

LAND CORNER RECORDATION CERTIFICATE
Filing Requirement of Act 74, Mich. P.A. 1970

For corners in

<u>KALKASKA</u>	Located in:	Corner Code #
(County)		
1998 REMONUMENTATION		
1. Public Land Survey	T <u>25N</u> R <u>R8W</u>	<u>G-3</u>
	T _____ R _____	_____
	T _____ R _____	_____
	T _____ R _____	_____
2. Property Controlling	S _____ T _____ R _____	_____
in Section	S _____ T _____ R _____	_____
3. Miscellaneous	S _____ T _____ R _____	_____
Property in Sec.	S _____ T _____ R _____	_____

**SURVEY &
REMONUMENTATION**

FEB 22 1999

SECTION

Register of Deeds Stamp & File Number

4. Lot No. _____, Recorded Plat _____

5. Private Claims _____

I, EUGENE FARRIER, in a field survey on October 30, 1998 do hereby state that under requirements of P.A. 74, Michigan P.A. of 1970, the corner points mentioned in lines 1 and 2 above were in conformance with regulations and rules therefore as required in the current manual of survey instructions of the United States Department of the Interior, Bureau of Land Management or by a decree of a Court of Law and /or that the corner points mentioned in lines 3, 4 and 5 above were in conformance with the rules of the Michigan Board of Land Surveyors or by a Decree of a Court of Law; established, re-established, monumented, recovered, found as expressed below:

	A	B	C	D	E	F	G	H	I	J	K	L
1												
2	6		5			4		3		2		1
3							●					
4	7		8			9		10		11		12
5												
6	18		17			16		15		14		13
7												
8	19		20			21		22		23		24
9												
10	30		29			28		27		26		25
11												
12	31		32			33		34		35		36
13												

NOTE: Not more than 2 corners, all in the same town and range, may be recorded on this certificate.

A. Description of original monument and accessories and/or subsequent restoration:

G-3; Sec. Cor. Common to Secs. 3, 4, 9, & 10, T25N-R8W, Springfield Township
1852, GLO. Sub. resurvey by V.W. Cankin D.S.; set post at corner, Hemlock 30", N58°W, 46 Lks. (30.36'); Beech 12", S79°E, 24 Lks (15.84')
1876, Road Survey by D.E. McVean CS., Co. Survey Bk., Pg. 2; Measured to fd. cor., no/acc.
1911, Sec. Sub. Survey by W.S. Merrill CS., FB # 47, Pg. 29; established corner and set hardwood stake; one old Gov't B.T. Hemlock N58°W, Much decayed, no/acc.

B. Description of corner evidence found and/or method applied in restoring or reestablishing corner:

G-3; Sec. Cor. Common to Secs. 3, 4, 9, & 10, T25N-R8W, Springfield Township
Found and accepted 1/2" iron & ca #12026, 9' South of centerline road and 15' East of O.H.P.
Pulled and set 5/8" X 36", re-bar w/brass cap.
No G.L.O. witnesses were found.

Kalkaska County Peer Group accepted the above monument as the best available evidence of the position of the original corner.


Ratified by Peer Group
P.A. 345 - 1990 Kalkaska County

Chairman Eugene Farrier

Date 2-2-99

C. Description of monument for corner and accessories established to perpetuate locating the position of the corner:

G-3; Sec. Cor. Common to Secs. 3, 4, 9, & 10, T25N-R8W, Springfield Township
Found and accepted 1/2" iron & ca #12026, 9' South of centerline road and 15' East of O.H.P.
S40°W, 27.44' - Power Pole, set nail and washer
N20°W, 49.62' - Power Pole, set nail and washer
N12°E, 37.33' - 6" Poplar, set nail and washer
N57°E, 37.84' - 6" Poplar, set nail and washer

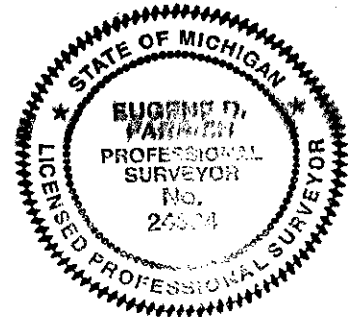

Signed by Eugene Farrier
Michigan License No. 24594

Date 2-8-99 Surveyor's

3012667
Page: 1 of 1
02/10/1999 08:35A

Kalkaska County REMON 9.00 LB: 5 PG: 322