

LAND CORNER RECORDATION CERTIFICATE
Filing Requirement of Act 74, Mich. P.A. 1970

**SURVEY &
REMONUMENTATION**

FEB 22 1999

SECTION

Register of Deeds Stamp & File Number

For corners in

KALKASKA
(County)

Located In: _____ Corner Code # _____

1998 REMONUMENTATION

- | | | |
|------------------------------------|--------------------------|------------|
| 1. Public Land Survey | T <u>25N</u> R <u>8W</u> | <u>G-4</u> |
| | T _____ R _____ | _____ |
| | T _____ R _____ | _____ |
| | T _____ R _____ | _____ |
| 2. Property Controlling in Section | S _____ T _____ R _____ | _____ |
| | S _____ T _____ R _____ | _____ |
| 3. Miscellaneous Property in Sec. | S _____ T _____ R _____ | _____ |
| | S _____ T _____ R _____ | _____ |

4. Lot No. _____, Recorded Plat _____

5. Private Claims _____

	A	B	C	D	E	F	G	H	I	J	K	L
1												
2	6		5		4		3		2		1	
3												
4	7		8		9		10		11		12	
5												
6	18		17		16		15		14		13	
7												
8	19		20		21		22		23		24	
9												
10	30		29		28		27		26		25	
11												
12	31		32		33		34		35		36	
13												

I, EUGENE FARRIER, in a field survey on November 4, 1998 do hereby state that under requirements of P.A. 74, Michigan P.A. of 1970, the corner points mentioned in lines 1 and 2 above were in conformance with regulations and rules therefore as required in the current manual of survey instructions of the United States Department of the Interior, Bureau of Land Management or by a decree of a Court of Law and for that the corner points mentioned in lines 3, 4 and 5 above were in conformance with the rules of the Michigan Board of Land Surveyors or by a Decree of a Court of Law; established, re-established, monumented, recovered, found as expressed below:

NOTE: Not more than 2 corners, all in the same town and range, may be recorded on this certificate.

A. Description of original monument and accessories and/or subsequent restoration:

- G-4: 1/4 Cor. Common to Secs. 9 & 10, T25N-R8W, Springfield Township
1852, G.L.O. Sub. resurvey by V.W. Cankin D.S.; set corner; Lynn 8", S24°W, 26 Lks. (17.16'); Sugar 10", N30°E, 4 Lks. (2.64') Dry Bed 3 Lk. stream in 1 Ch. wide swail, North, 13.54 Ch. (893.64')
1908, Sec. Sub. Survey by W.S. Merrill CS., FB # 47, Pg. 29; shows cor., no description; Elm 6", S34°E, 27 Lks. (17.82'); Maple 16", N38°E, 41 1/2 Lks. (27.39')
7-20-83, R. Mitchell, set 1/2" re-rod w/ cap #28417 from found witness tree (Merrill Survey 1904, Maple 16" N38°E, 41 1/2 Lks) LCRC, Liber 2, Pg. 259
6-3-87, R. Mitchell, found 1/2" re-rod w/cap #28417, Liber 3, Pg. 124, Cert. of Survey
7-19-94, N. Way, set iron w/cap #28432 midway and on line between Section corners, Cert. of Survey

B. Description of corner evidence found and/or method applied in restoring or reestablishing corner:

- G-4: 1/4 Cor. Common to Secs. 9 & 10, T25N-R8W, Springfield Township
Found and accepted iron & cap #28417 16' West of old fence thru trees (as recorded in LCRC and previous Cert. of Surveys, excluding N Way survey) Pulled and set 5/8" X 36" re-rod w/ alum. cap
No G.L.O. witnesses were found.
Kalkaska County Peer Group accepted the above monument as the best available evidence of the position of the original corner.


Ratified by Peer Group
P.A. 345 - 1990 Kalkaska County
Chairman Eugene Farrier
Date 2-2-99

C. Description of monument for corner and accessories established to perpetuate locating the position of the corner:

- G-4: 1/4 Cor. Common to Secs. 9 & 10, T25N-R8W, Springfield Township
Found and accepted iron & cap #28417 16' West of old fence thru trees. Pulled and set 5/8" X 36" re-rod w/ alum. cap
N38°E, 29.86' - 8" Maple, set nail & washer
N65°E, 17.35' - 14" Basswood, set nail & washer
S55°E, 15.06' - 10" Ash, set nail & washer
N70°W, 9.59' - 4" Maple, set nail & washer
N43°E, 33.50' - found spike (N. Way's corner position)

Signed by Eugene Farrier
Michigan License No. 24594

Date 2-8-99

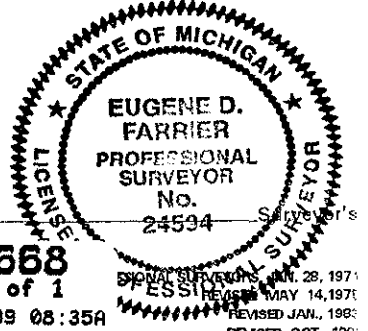

3012668
Page: 1 of 1
02/10/1999 08:35A
LB: 5 PG: 323