

LAND CORNER RECORDATION CERTIFICATE
Filing Requirement of Act 74, Mich. P.A. 1970

For corners in

KALKASKA Located In: Corner Code #
 (County)
 1998 REMONUMENTATION
 1. Public Land Survey T 25N R 8W G-5
 T R
 T R
 T R
 2. Property Controlling S T R
 in Section S T R
 3. Miscellaneous S T R
 Property in Sec. S T R

**SURVEY &
 REMONUMENTATION**

FEB 22 1999

SECTION

Register of Deeds Stamp & File Number

4. Lot No. _____, Recorded Plat _____

5. Private Claims _____

I, EUGENE FARRIER, in a field survey on November 4, 1998 do hereby state that under requirements of P.A. 74, Michigan P.A. of 1970, the corner points mentioned in lines 1 and 2 above were in conformance with regulations and rules therefore as required in the current manual of survey instructions of the United States Department of the Interior, Bureau of Land Management or by a decree of a Court of Law and for that the corner points mentioned in lines 3, 4 and 5 above were in conformance with the rules of the Michigan Board of Land Surveyors or by a Decree of a Court of Law; established, re-established, monumented, recovered, found as expressed below:

1	A	B	C	D	E	F	G	H	I	J	K	L
2		6		5		4		3		2		1
3												
4		7		8		9		10		11		12
5												
6		18		17		16		15		14		13
7												
8		19		20		21		22		23		24
9												
10		30		29		28		27		26		25
11												
12		31		32		33		34		35		36
13												

NOTE: Not more than 2 corners, all in the same town and range, may be recorded on this certificate.

A. Description of original monument and accessories and/or subsequent restoration:

G-5: Sec. Cor. Common to Secs. 9, 10, 15, & 16, T25N-R8W, Springfield Township
 1852, G.L.O. Sub. resurvey by V.W. Cankin D.S.; set post at corner; Sugar 14", N14°E, 39 Lks. (25.74'); Hemlock 30", S29°W, 45 Lks. (29.70')
 1906, 1907, 1911, Sec. Sub. survey by W.S. Merrill CS., FB # 22, Pg. 76; FB # 22, pg. 141 & FB # 47, Pg. 29 shows corner, no description or accessories.
 9-18-78, H. Fluharty, set 5/8" X 18" iron w/cap at 3-way fence corner, LCRC, Liber 2, Pg. 116
 7-20-83, R. Mitchell, found 1/2" re-rod as recorded in Liber 2, Pg. 116
 7-20-83, R. Mitchell, found 1/2" re-rod as recorded in Liber 2, Pg. 116
 10-28-86, R. Mitchell, set 1/2" X 18" re-rod & cap #28417 by prorating to 1/4 corner to West & G.L.O. swamp call to East, falls on CL of East-West road projected 33' East of corner fence post (N40°E, 1/2" re-rod w/cap #12026, 19.49'; N88°W, 5/8" re-rod w/cap #18223, 33.00') Liber 3, Pg. 71, Cert. of Survey
 1-2-87, R. Mitchell, found 1/2" re-rod w/cap #28417, Liber 3, Pg. 93-94, Cert. of Survey

Ratified by Peer Group
P.A. 345 - 1990 Kalkaska County
 Chairman Eugene Farrier
 Date 2-2-99

"Continued on Page 2"

B. Description of corner evidence found and/or method applied in restoring or reestablishing corner:


G-5: Sec. Cor. Common to Secs. 9, 10, 15, & 16, T25N-R8W, Springfield Township
 Found and accepted iron & cap #28417 on CL of East-West road projection & 32' East of corner fence post position (as recorded in LCRC Liber 2, Pg. 324 & previous Cert. of Surveys) Pulled and set 5/8" X 36" re-bar w/ alum. cap.
 S36°W, 6.90' - 10" Basswood, found nail
 N67°W, 26.37' - 14" Beech, found nail
 N15°W, 4.28' - 5" Maple, found nail
 No G.L.O. witnesses were found.
 Kalkaska County Peer Group accepted the above monument as a careful and faithful reestablishment of the position of the original corner.

C. Description of monument for corner and accessories established to perpetuate locating the position of the corner:

G-5: Sec. Cor. Common to Secs. 9, 10, 15, & 16, T25N-R8W, Springfield Township
 Found and accepted iron & cap #28417 on CL of East-West road projection & 32' East of corner fence post position. Pulled and set 5/8" X 36" re-bar w/ alum. cap.
 N40°E, 19.49' - iron & cap #12026
 S36°W, 6.90' - 10" Basswood, found nail
 West, 33.10' - iron & cap #18223
 N67°W, 26.37' - 14" Beech, found nail
 N15°W, 4.28' - 5" Maple, found nail

Signed by Eugene Farrier
 Michigan License No. 24594

Date 2-8-99 Surveyor's

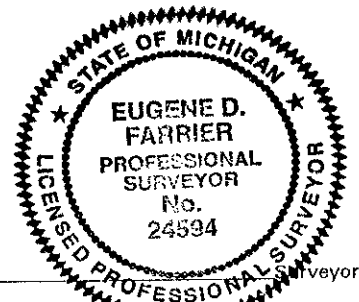

**SURVEY &
REMONUMENTATION**

Continued from Page 1

FEB 22 1999

SECTION

G-5: Sec. Cor. Common to Secs. 9, 10, 15, & 16, T25N-R8W, Springfield Township

2-13-87, R. Mitchell, found 1/2" re-rod w/cap #28417, Liber 3, Pg. 97-99, Cert. of Survey

6-3-87, R. Mitchell, set 1/2" re-rod w/cap #28417 by prorating to corner 1/2 mile to West and U.S. swamp call to the East and on projection of road centerlines to East and West & 33' East of corner fence post for fences West & South. This agrees well with Merrill distance for 1 mile to the East, LCFC, Liber 2, Pg. 324

6-3-87, R. Mitchell, found 1/2" iron & cap #28417, Liber 3, Pg. 125, Cert. of Survey

6-3-87, R. Mitchell, found 1/2" iron & cap #28417, Liber 3, Pg. 124, Cert. of Survey

6-3-87, R. Mitchell, found 1/2" iron & cap #28417, Liber 3, Pg. 124, Cert. of Survey

1-20-94, E. Farrier, found 1/2" iron, Cert. of Survey

1-20-94, E. Farrier, found 1/2" iron, Cert. of Survey