

SURVEY & RECORDATION

LAND CORNER RECORDATION CERTIFICATE
Filing Requirement of Act 74, Mich. P.A. 1970

MAR 11 2000

For corners in

KALKASKA (County)

Located In:

Corner Code #

SECTION

1999 REMONUMENTATION

1. Public Land Survey

T 25N R 8W G-8

T R

T R

T R

2. Property Controlling in Section

S T R

S T R

3. Miscellaneous Property in Sec.

S T R

S T R



3020129 Page: 1 of 1 02/04/2000 03:15P REMON LB: 6 PG: 75

Kalkaska County Joan Hall, Register

4. Lot No. , Recorded Plat

5. Private Claims

Grid table with columns A-M and rows 1-13. Cell G-8 contains a black dot.

I, EUGENE FARRIER, in a field survey on November 1, 1999 do hereby state that under requirements of P.A. 74, Michigan P.A. of 1970, the corner points mentioned in lines 1 and 2 above were in conformance with regulations and rules therefore as required in the current manual of survey instructions of the United States Department of the Interior, Bureau of Land Management or by a decree of a Court of Law and /or that the corner points mentioned in lines 3, 4 and 5 above were in conformance with the rules of the Michigan Board of Land Surveyors or by a Decree of a Court of Law; established, re-established, monumented, recovered, found as expressed below:

NOTE: Not more than 2 corners, all in the same town and range, may be recorded on this certificate.


A. Description of original monument and accessories and/or subsequent restoration:

G-8: 1/4 Cor. Common to Sec. 21 & 22, T25N-R8W, Springfield Township 1852, G.L.O. Resurvey, by V.W. Caukin (Deputy Surveyor) Co. Survey Notes, Pg. 296, set corner, Sugar 7", S58°E, 26 Lks. (17.16'); Sugar 9", N40°W, 15 Lks. (9.8') 1972, LCRC & Survey, by J.L. Wilcox, ( LCRC recorded in Liber 1, Pg. 105), set 1/2" rod on line and 1/2 way between Section corners, 2' East of centerline of road, 19' North of fence to West; 7' South of fence to East, N55°W, power pole, 40.10'; S60°W, fence corner post, 42.92'. 1977, LCRC & Survey, by J.L. Fletcher, (LCRC recorded in Liber 2, Pg. 25), found 1/2" iron w/cap, 3" Cherry S60°W, 43.95'; Power pole, N52°W, 40.12'; SW corner wood frm. building, N75°E, 79.21' 1985, Survey, by N. DeYoung, recorded in Liber 3, Pg. 7, found 1/2" rod, Power pole, N40°W, 40.2'; 1/2" rod, S45°W, 47.1'; 5" Cherry, N35°E, 43.7'; 6" Cherry, East 25.8' 1986, Survey, by R. Mitchell, found 1/2" rerod #14102, Power pole, N58°W, 40.22'; 6" Cherry, N34°E, 44.00'; 8" Cherry, S82°E, 26.25'; 4" Cherry, S52°W, 43.94' 1995, Survey, by D. Grier, recorded Liber 4, Pg. 327, found 1/2" rerod, Power pole, N40°W, 40.2'; 1/2" rerod, S45°W, 47.1'; Cherry 5", N55°E, 43.7'; Cherry 6", East, 25.8' 1998, Survey, by Farrier Surveying, found iron & cap #7, same witnesses as D. Grier (1995)

B. Description of corner evidence found and/or method applied in restoring or reestablishing corner:

G-8: 1/4 Cor. Common to Sec. 21 & 22, T25N-R8W, Springfield Township The 1/4 corner set by Wilcox in 1972 was set M.P.O.L. In 1978, Mears Engineering found a 1 1/4" well point at G-7 (NW cor. Section 22) which is 5.6' South, and 14.6' West of the corner Wilcox used to set G-8. In 1999, Farrier found a 1 1/4" pipe at the 1/8 corner between G-8 & G-7. Therefore he held the found 1 1/4" pipes & doubled them over to position G-8, which falls about 17.7' West of the one Wilcox set. This position generally fits the centerline of the North 2000 feet of the North-South road and falls on the centerline of the road West. Set 5/8" iron & brass cap. N25°W, 28.75', power pole, set nail & cap N50°E, 52.62', 6" Cherry, set nail & cap S85°E, 50.60', Mitchell Iron, #28417 S27°W, 36.58', Fletcher Iron No G.L.O. witnesses were found.

Ratified by Peer Group P.A. 345 - 1990 Kalkaska County Chairman Eugene Farrier Date 02-03-00

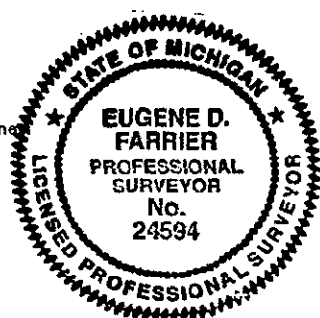

C. Description of monument for corner and accessories established to perpetuate locating the position of the corner:

G-8: 1/4 Cor. Common to Sec. 21 & 22, T25N-R8W, Springfield Township Set 5/8" iron & brass cap. N25°W, 28.75', power pole, set nail & cap N50°E, 52.62', 6" Cherry, set nail & cap S85°E, 50.60', Mitchell Iron, #28417 S27°W, 36.58', Fletcher Iron Kalkaska County Peer Group accepted the above monument as a careful and faithful reestablishment of the position of the original corner.

Signed by Eugene Farrier Michigan License No. 24594

Date 02-04-00 Surveyor's