

LAND CORNER RECORDATION CERTIFICATE
Filing Requirement of Act 74, Mich. P.A. 1970

For corners in

KALKASKA Located In: _____ Corner Code # _____
 (County)
 1998 REMONUMENTATION
 1. Public Land Survey T 25N R 8W H-5
 T _____ R _____
 T _____ R _____
 T _____ R _____
 2. Property Controlling S _____ T _____ R _____
 in Section S _____ T _____ R _____
 3. Miscellaneous S _____ T _____ R _____
 Property in Sec. S _____ T _____ R _____

**SURVEY &
 REMONUMENTATION**

FEB 22 1999

SECTION

Register of Deeds Stamp & File Number

4. Lot No. _____, Recorded Plat _____

5. Private Claims _____

I, EUGENE FARRIER, in a field survey on October 28, 1998 do hereby state that under requirements of P.A. 74, Michigan P.A. of 1970, the corner points mentioned in lines 1 and 2 above were in conformance with regulations and rules therefore as required in the current manual of survey instructions of the United States Department of the Interior, Bureau of Land Management or by a decree of a Court of Law and /or that the corner points mentioned in lines 3, 4 and 5 above were in conformance with the rules of the Michigan Board of Land Surveyors or by a Decree of a Court of Law; established, re-established, monumented, recovered, found as expressed below:

| | | | | | | | | | | | | |
|----|----|---|----|---|----|---|----|---|----|---|----|---|
| | A | B | C | D | E | F | G | H | I | J | K | L |
| 1 | | | | | | | | | | | | |
| 2 | 6 | | 5 | | 4 | | 3 | | 2 | | 1 | |
| 3 | | | | | | | | | | | | |
| 4 | 7 | | 8 | | 9 | | 10 | | 11 | | 12 | |
| 5 | | | | | | | | | | | | |
| 6 | 18 | | 17 | | 16 | | 15 | | 14 | | 13 | |
| 7 | | | | | | | | | | | | |
| 8 | 19 | | 20 | | 21 | | 22 | | 23 | | 24 | |
| 9 | | | | | | | | | | | | |
| 10 | 30 | | 29 | | 28 | | 27 | | 26 | | 25 | |
| 11 | | | | | | | | | | | | |
| 12 | 31 | | 32 | | 33 | | 34 | | 35 | | 36 | |
| 13 | | | | | | | | | | | | |

NOTE: Not more than 2 corners, all in the same town and range, may be recorded on this certificate.

A. Description of original monument and accessories and/or subsequent restoration:

H-5: 1/4 Cor. Common to Secs. 10 & 15, T25N-R8W, Springfield Township
 1852, GLO. Sub. resurvey by V.W. Cankin D.S.; set corner; Tamarack 6", N85°W, 26 Lks. (17.16'); Tamarack 6", S35°E, 7 Lks. (4.62 East edge swamp, East, 0.38 Ch. (25.1')
 1906, Sec. Sub. Survey by W.S. Merrill CS. FB # 22, pg. 76; shows cor. with pro. dist. no/acc.
 1911, Sec. Sub. Survey by W.S. Merrill CS. FB # 47, Pg. 29; shows cor. only, no/acc.
 8-10-88, R. Mitchell, set 1/2" re-bar w/ cap #28417, midway between Section corners and in CL East-West road, Liber 3, Pg. 235

B. Description of corner evidence found and/or method applied in restoring or reestablishing corner:


H-5: 1/4 Cor. Common to Secs. 10 & 15, T25N-R8W, Springfield Township
 Found and accepted 1/2" iron & cap #28417 in CL road (as recorded in previous Cert. of Surveys) Pulled and set 5/8" X 18" re-bar w/brass cap in mon. box.
 No G.L.O. witnesses were found.
 Kalkaska County Peer Group accepted the above monument as a careful and faithful reestablishment of the position of the original corner

Ratified by Peer Group
P.A. 345 - 1990 Kalkaska County

Chairman Eugene Farrier
 Date 2-2-99

C. Description of monument for corner and accessories established to perpetuate locating the position of the corner:

H-5: 1/4 Cor. Common to Secs. 10 & 15, T25N-R8W, Springfield Township
 Found and accepted 1/2" iron & cap #28417 in CL road. Pulled and set 5/8" X 18" re-bar w/brass cap in mon. box.
 N60°E, 66.66' - Power pole, set nail & washer
 S60°W, 62.18' - Face of East steel gate post
 N25°W, 46.95' - Face of West steel gate post
 North, 33.07' - Iron & cap #28417

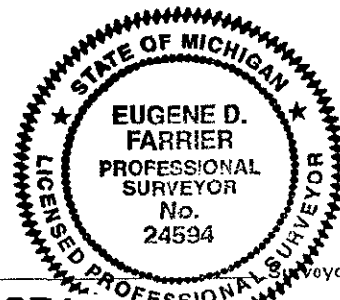

Signed by Eugene Farrier
 Michigan License No. 24594

Date 2-8-99



3012671
 Page: 1 of 1
 02/10/1999 08:36A

PROFESSIONAL SURVEYORS, JAN. 28, 1971
 REVISED MAY 14, 1971
 REVISED JAN., 1981
 REVISED OCT., 1995