

MAR 01 2000

LAND CORNER RECORDATION CERTIFICATE
Filing Requirement of Act 74, Mich. P.A. 1970

SECTION

For corners in

KALKASKA (County)

Located In:

Corner Code #

1999 REMONUMENTATION

1. Public Land Survey

T 25N R 8W

H-7

2. Property Controlling in Section

S T R

3. Miscellaneous Property in Sec.

S T R



3020131
Page: 1 of 1
02/04/2000 03:15P
REMON
LB: 6 PG: 77

Register of Deeds Stamp & File Number

4. Lot No. , Recorded Plat

5. Private Claims

Grid table with columns A-M and rows 1-13. A dot is marked at the intersection of column H and row 7.

I, EUGENE FARRIER, in a field survey on November 1, 1999 do hereby state that under requirements of P.A. 74, Michigan P.A. of 1970, the corner points mentioned in lines 1 and 2 above were in conformance with regulations and rules therefore as required in the current manual of survey instructions of the United States Department of the Interior, Bureau of Land Management or by a decree of a Court of Law and for that the corner points mentioned in lines 3, 4 and 5 above were in conformance with the rules of the Michigan Board of Land Surveyors or by a Decree of a Court of Law; established, re-established, monumented, recovered, found as expressed below:

NOTE: Not more than 2 corners, all in the same town and range, may be recorded on this certificate.

A. Description of original monument and accessories and/or subsequent restoration:

H-7: 1/4 Cor. Common to Sec. 15 & 22, T25N-R8W, Springfield Township

1852, G.L.O. Resurvey, by V.W. Caukin (Deputy Surveyor) Co. Survey Notes, Pg. 293, set corner, Sugar 30", North 78 Lks. (51.48'); Sugar 18" S55°E, 18 Lks. (11.88')
1908, Survey, by W.S. Merrill (Co. Surveyor) Co. Survey Bk 22, Pgs. 76 & 77, found 8T Maple and old stake
1988, Survey, by R. Mitchell, set 1/2" rebar by splitting r.o.w. fences and on N-S fences
1996 & 1998, Survey, by Farrier Surveying, recorded in Liber 4, Pgs. 369 & 370, found 1/2" rerod w/ cap #28417, N07°E, 12.22', Maple 8"; N69°E, 29.02', Maple 8"; S58°E, 26.71', 8" Maple; S07°E, 14.19', 8" Ironwood

B. Description of corner evidence found and/or method applied in restoring or reestablishing corner:

H-7: 1/4 Cor. Common to Sec. 15 & 22, T25N-R8W, Springfield Township


Found and accepted 1/2" iron & cap #28417 in centerline of E-W road.

N07°E, 12.22, 8" Maple, found nail
N69°E, 29.02', 8" Twin Maple, found nail
S58°E, 26.71', 10" Maple, set nail & washer over nail
S07°E, 14.19', 8" Cherry, found nail
North, 33.00', Iron & cap #24594
No G.L.O. witnesses were found.

Ratified by Peer Group
P.A. 345 - 1990 Kalkaska County

Chairman [Signature]

Date 02-03-00

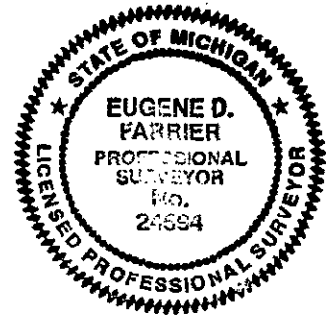

C. Description of monument for corner and accessories established to perpetuate locating the position of the corner:

H-7: 1/4 Cor. Common to Sec. 15 & 22, T25N-R8W, Springfield Township

Found and accepted 1/2" iron & cap #28417 in centerline of E-W road. Pulled & replaced 5/8" X18" rerod w/brass cap.

N07°E, 12.22, 8" Maple, found nail
N69°E, 29.02', 8" Twin Maple, found nail
S58°E, 26.71', 10" Maple, set nail & washer over nail
S07°E, 14.19', 8" Cherry, found nail
North, 33.00', Iron & cap #24594
Kalkaska County Peer Group accepted the above monument as the best available evidence of the position of the original corner.

Signed by Eugene Farrier
Michigan License No. 24594

Date 02-04-00 Surveyor's