

MAR 01 2000

LAND CORNER RECORDATION CERTIFICATE
Filing Requirement of Act 74, Mich. P.A. 1970

SECTION

For corners in

KALKASKA (County)

Located In:

Corner Code #

1999 REMONUMENTATION
1. Public Land Survey

T 25N R 8W

H-9

2. Property Controlling in Section

S T R

3. Miscellaneous Property in Sec.

S T R



3020132
Page: 1 of 1
02/04/2000 03:18P
REMON
LB: 6 PG: 78

Register of Deeds Stamp & File Number

4. Lot No. , Recorded Plat

5. Private Claims

Grid table with columns A-M and rows 1-13. A dot is marked at the intersection of column H and row 9.

I, EUGENE FARRIER, in a field survey on November 17, 1999 do hereby state that under requirements of P.A. 74, Michigan P.A. of 1970, the corner points mentioned in lines 1 and 2 above were in conformance with regulations and rules therefore as required in the current manual of survey instructions of the United States Department of the Interior, Bureau of Land Management or by a decree of a Court of Law and/or that the corner points mentioned in lines 3, 4 and 5 above were in conformance with the rules of the Michigan Board of Land Surveyors or by a Decree of a Court of Law; established, re-established, monumented, recovered, found as expressed below:

NOTE: Not more than 2 corners, all in the same town and range, may be recorded on this certificate.


A. Description of original monument and accessories and/or subsequent restoration:

H-9: 1/4 Cor. Common to Sec. 22 & 27, T25N-R8W, Springfield Township
1852, G.L.O. Resurvey, by V.W. Caukin (Deputy Surveyor) Co. Survey Notes Pg 317, Sugar 19", S32°W, 30 Lks; Birch 10", N5°E, 35 Lks
1912, Survey, by Fargo, no US evidence, set iron pipe, W. Pine 50", 1.64 1/2 Ch; W. Pine stump, N37°W, 1.58 Ch
1974, Survey, by Fluharty, set iron & cap centerline Lund Road; 6" Pine, S03°W, 39.09'; 27" Pine, N20°W, 38.87'; 20" Pine, S65°E, 88.95'
1985, Survey, by N.B. DeYoung, recorded in Liber 3, Pg 7, found 1/2" rod, North 33.0', 1/2" rod; N15°W, 38.90', 32" Pine; South 39.10', 6" Pine; S40°E, 42.85', 6" Pine
1995, Survey, by D.Grier Jr, recorded in Liber 4, Pg 327, same wit. as DeYoung (1985)

B. Description of corner evidence found and/or method applied in restoring or reestablishing corner:

H-9: 1/4 Cor. Common to Sec. 22 & 27, T25N-R8W, Springfield Township
Found 1/2" iron & cap #18223 in centerline E-W Road.
North, 33.02', iron & cap #20706
N28°E, 36.28', 10" W. Pine, found nail, added nail & washer
S33°E, 42.74', 14" W. Pine, found nail, added nail & washer
South 32.96', iron & cap #11368
No G.L.O. witnesses were found.

Ratified by Peer Group
P.A. 345 - 1990 Kalkaska County
Chairman Eugene FARRIER
Date 02-03-00

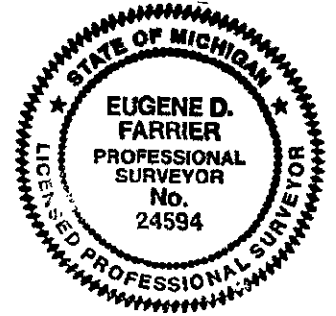

C. Description of monument for corner and accessories established to perpetuate locating the position of the corner:

H-9: 1/4 Cor. Common to Sec. 22 & 27, T25N-R8W, Springfield Township
Found 1/2" iron & cap #18223 in centerline E-W Road. Pulled & set 5/8" X 18" rerod w/brass cap in mon. box.
North, 33.02', iron & cap #20706
N28°E, 36.28', 10" W. Pine, found nail, added nail & washer
S33°E, 42.74', 14" W. Pine, found nail, added nail & washer
South 32.96', iron & cap #11368
Kalkaska County Peer Group accepted the above monument as the best available evidence of the position of the original corner.

Signed by Eugene FARRIER
Michigan License No. 24594

Date 02-03-00 Surveyor's