

LAND CORNER RECORDATION CERTIFICATE
Filing Requirement of Act 74, Mich. P.A. 1970

For corners in

KALKASKA Located In: Corner Code #
 (County)
 1998 REMONUMENTATION
 1. Public Land Survey T 25N R 8W I-5
 T _____ R _____
 T _____ R _____
 T _____ R _____
 2. Property Controlling S _____ T _____ R _____
 in Section S _____ T _____ R _____
 3. Miscellaneous S _____ T _____ R _____
 Property in Sec. S _____ T _____ R _____

**SURVEY &
 REMONUMENTATION**

FEB 22 1999

SECTION

Register of Deeds Stamp & File Number

4. Lot No. _____, Recorded Plat _____
 5. Private Claims _____

	A	B	C	D	E	F	G	H	I	J	K	L	M
1													
2	6		5		4		3		2		1		
3													
4	7		8		9		10		11		12		
5									●				
6	18		17		16		15		14		13		
7													
8	19		20		21		22		23		24		
9													
10	30		29		28		27		26		25		
11													
12	31		32		33		34		35		36		
13													

I, EUGENE FARRIER, in a field survey on October 28, 1998 do hereby state that under requirements of P.A. 74, Michigan P.A. of 1970, the corner points mentioned in lines 1 and 2 above were in conformance with regulations and rules therefore as required in the current manual of survey instructions of the United States Department of the Interior, Bureau of Land Management or by a decree of a Court of Law and /or that the corner points mentioned in lines 3, 4 and 5 above were in conformance with the rules of the Michigan Board of Land Surveyors or by a Decree of a Court of Law; established, re-established, monumented, recovered, found as expressed below:

NOTE: Not more than 2 corners, all in the same town and range, may be recorded on this certificate.

A. Description of original monument and accessories and/or subsequent restoration:

I-5 Sec. Cor. Common to Secs. 10, 11, 14 & 15, T25N-R8W, Springfield Township
 1852, GLO. Sub. resurvey by V.W. Cankin D.S.; set post at corner; Hemlock 20", N15°W, 16 Lks. (10.56'); W. Pine 30", S47°W, 24 Lks. (15.84')
 1906, 1909, 1911, Sec. Sub. Survey by W.S. Merrill CS., FB # 22, pg. 77, FB # 23, Pg. 158 & FB # 47, Pg. 29 shows corner only, no/acc.
 1918, Sec. Sub. Survey By W.S. Merrill CS., FB # 24, Pg. 1; iron buried for corner, Pine 8", S66°E, 50 Lks. (33.00')
 11-20-95, E. Farrier, found 1/2" iron pipe in CL road int., Cert. of Survey
 12-13-96, E. Farrier, found 1/2" iron pipe in CL road int., Cert. of Survey
 12-2-98, E. Farrier, found 1/2" iron pipe in CL road int., Cert. of Survey

B. Description of corner evidence found and/or method applied in restoring or reestablishing corner:

I-5 Sec. Cor. Common to Secs. 10, 11, 14 & 15, T25N-R8W, Springfield Township
 Found and accepted 1/2" iron pipe in CL 4-way rd. int. (as shown in previous Cert. of Surveys) Pulled and set 5/8" X 18" re-bar w/brass cap in mon. box
 No G.L.O. witnesses were found.
 Kalkaska County Peer Group accepted the above monument as the best available evidence of the position of the original corner.

Ratified by Peer Group
P.A. 345 - 1990 Kalkaska County


Chairman Eugene Farrier
 Date 2-2-99

C. Description of monument for corner and accessories established to perpetuate locating the position of the corner:

I-5 Sec. Cor. Common to Secs. 10, 11, 14 & 15, T25N-R8W, Springfield Township
 Found and accepted 1/2" iron pipe in CL 4-way rd. int. Pulled and set 5/8" X 18" re-bar w/brass cap in mon. box
 S45°E, 46.25' - iron & cap #24594
 S40°W, 51.04' - r.r. tie fence post, set nail & washer
 N62°W, 70.68' - Wood guard post (telephone), set nail & washer
 N55°E, 62.37' - 10" Poplar, set nail & washer

Signed by Eugene Farrier
 Michigan License No. 24594

Date 2-8-99

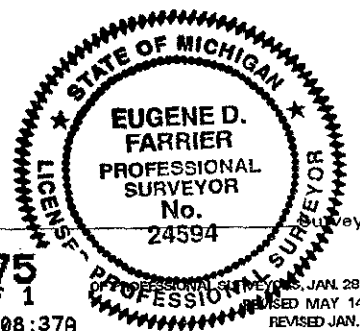

3012675
 Page: 1 of 1
 02/10/1999 08:37A
 LB: 5 PG: 330

REVISED MAY 14, 197
 REVISED JAN., 198
 REVISED OCT., 198