

MAR 01 2000

LAND CORNER RECORDATION CERTIFICATE
Filing Requirement of Act 74, Mich. P.A. 1970

For corners in

SECTION

KALKASKA (County)
1999 REMONUMENTATION
1. Public Land Survey
2. Property Controlling in Section
3. Miscellaneous Property in Sec.
Located in: T 25N R 8W
Corner Code #: I-6



3020133
Page: 1 of 1
02/04/2000 03:16P
REMON
LB: 6 PG: 79

Register of Deeds Stamp & File Number

4. Lot No. , Recorded Plat
5. Private Claims

I, EUGENE FARRIER, in a field survey on November 1, 1999 do hereby state that under requirements of P.A. 74, Michigan P.A. of 1970, the corner points mentioned in lines 1 and 2 above were in conformance with regulations and rules therefore as required in the current manual of survey instructions of the United States Department of the Interior, Bureau of Land Management or by a decree of a Court of Law and /or that the corner points mentioned in lines 3, 4 and 5 above were in conformance with the rules of the Michigan Board of Land Surveyors or by a Decree of a Court of Law; established, re-established, monumented, recovered, found as expressed below:

Grid table with columns A-M and rows 1-13. A dot is marked at the intersection of column I and row 6.

NOTE: Not more than 2 corners, all in the same town and range, may be recorded on this certificate.


A. Description of original monument and accessories and/or subsequent restoration:

I-6: 1/4 Cor. Common to Sec. 14 & 15, T25N-R8W, Springfield Township
1852, G.L.O. Resurvey, by V.W. Caukin (Deputy Surveyor) Pg. 293, set corner, Beach 12", S74°W, 12 Lks (7.92'); Sugar 8", N87°E, 32 Lks. (21.12')
1918, Sec. Sub Survey, by W.S. Merrill (Co. Surveyor) Co. Survey Bk 24, Pgs. 1-3, found old corner & witness, set iron
1988, Survey, by E. Farrier (Co. Surveyor), set 1/2" iron rod in centerline N-S gravel road for East-West position and retraced Merrills East-West 1/4 line in Section 14, for North-South position. Corner falls 2' North of fence to East, 15' North of fence to West, Elm 6", N65°E, 33.19'; corner fence post, S73°W, 34.16'; power pole, N45°W, 41.88'; Spruce 6", S65°E, 46.34'
1996, Survey, by Farrier Surveying, found same as E. Farrier survey (1988)

B. Description of corner evidence found and/or method applied in restoring or reestablishing corner:

I-6: 1/4 Cor. Common to Sec. 14 & 15, T25N-R8W, Springfield Township
Found and accepted 1/2" X 18" re-rod w/ cap #24594 in centerline of North-South road, 2' North of fence to East and 15' North of fence to West.
N65°E, 33.19'- 12" Elm, found nail
East- 33.00', iron & cap #26460
S65°E, 46.34'- 12" S. Pine
N45°W, 41.88'- Power pole
No G.L.O. witnesses were found.

Ratified by Peer Group
P.A. 345 - 1990 Kalkaska County
Chairman Eugene Farrier
Date 02-03-00

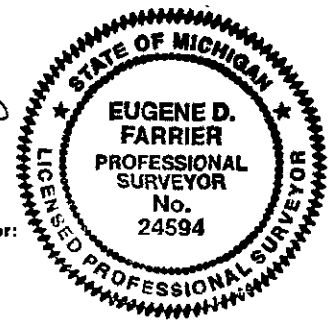

C. Description of monument for corner and accessories established to perpetuate locating the position of the corner:

I-6: 1/4 Cor. Common to Sec. 14 & 15, T25N-R8W, Springfield Township
Found and accepted 1/2" X 18" re-rod w/ cap #24594. Pulled & set 5/8" X 18" re-rod w/ brass cap.
N65°E, 33.19'- 12" Elm, found nail
East- 33.00', iron & cap #26460
S65°E, 46.34'- 12" S. Pine
N45°W, 41.88'- Power pole
Kalkaska County Peer Group accepted the above monument as a careful and faithful reestablishment of the position of the original corner.

Signed by Eugene Farrier
Michigan License No. 24594

Date 02-04-00 Surveyor's