

**LAND CORNER RECORDATION CERTIFICATE**  
**Filing Requirement of Act 74, Mich. P.A. 1970**

For corners in

<u>KALKASKA</u>	Located In:	Corner Code #
(County)		
1998 REMONUMENTATION		
1. Public Land Survey	T <u>25N</u> R <u>8W</u>	<u>J-5</u>
	T _____ R _____	_____
	T _____ R _____	_____
	T _____ R _____	_____
2. Property Controlling in Section	S _____ T _____ R _____	_____
	S _____ T _____ R _____	_____
3. Miscellaneous Property in Sec.	S _____ T _____ R _____	_____
	S _____ T _____ R _____	_____

**SURVEY & REMONUMENTATION**

**FEB 22 1999**


**SECTION**

*Register of Deeds Stamp & File Number*

4. Lot No. \_\_\_\_\_, Recorded Plat \_\_\_\_\_

5. Private Claims \_\_\_\_\_

I, EUGENE FARRIER, in a field survey on October 28, 1998, do hereby state that under requirements of P.A. 74, Michigan P.A. of 1970, the corner points mentioned in lines 1 and 2 above were in conformance with regulations and rules therefore as required in the current manual of survey instructions of the United States Department of the Interior, Bureau of Land Management or by a decree of a Court of Law and/or that the corner points mentioned in lines 3, 4 and 5 above were in conformance with the rules of the Michigan Board of Land Surveyors or by a Decree of a Court of Law; established, re-established, monumented, recovered, found as expressed below:

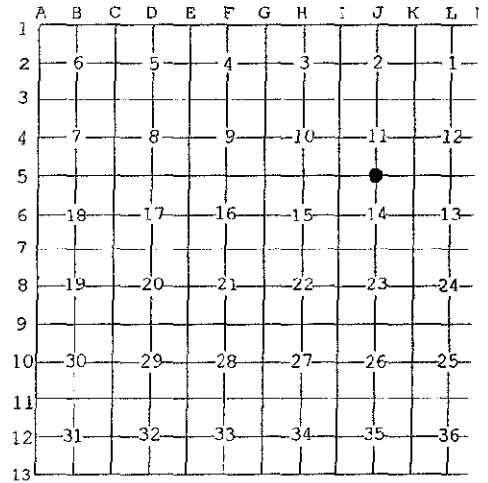

**NOTE: Not more than 2 corners, all in the same town and range, may be recorded on this certificate.**

**A. Description of original monument and accessories and/or subsequent restoration:**

J-5: 1/4 Cor. Common to Secs. 11 & 14, T25N-R8W, Springfield Township  
 1852, GLO. Sub. resurvey by V.W. Cankin D.S.; set post at corner; Y. Birch 14", N76°W, 30 Lks. (19.80'); Hemlock 14", S62°E, 37 Lks. (24.42'); Post is at edge swamp C. NW - SE  
 1909, 1918, Sec. Sub. Survey by W.S. Merrill CS., FB # 23, Pg. 158 & FB # 24, Pg. 1, shows corner only, no/acc.  
 11-20-95, E. Farrier, found 1" iron pipe in CL Road, Cert. of Survey  
 10-26-98, E. Farrier, found 1" iron pipe in CL Road, Cert. of Survey

**B. Description of corner evidence found and/or method applied in restoring or reestablishing corner:**

J-5: 1/4 Cor. Common to Secs. 11 & 14, T25N-R8W, Springfield Township  
 Found and accepted 1" iron pipe in CL East-West road on Trail Road to North (as shown in previous Cert. of Surveys) Pulled and set 5/8" X 18" re-bar w/ brass cap in mon. box.  
 S45°W, 37.88' - 12" Cedar, found nail  
 N25°W, 36.90' - iron & cap #24594  
 No G.L.O. witnesses were found.  
 Kalkaska County Peer Group accepted the above monument as the best available evidence of the position of the original corner.

**Ratified by Peer Group**  
**P.A. 345 - 1990 Kalkaska County**


Chairman Eugene Farrier  
 Date 2-2-99

**C. Description of monument for corner and accessories established to perpetuate locating the position of the corner:**

J-5: 1/4 Cor. Common to Secs. 11 & 14, T25N-R8W, Springfield Township  
 Found and accepted 1" iron pipe in CL East-West road on Trail Road to North. Pulled and set 5/8" X 18" re-bar w/ brass cap in mon. box  
 S45°W, 37.88' - 12" Cedar, found nail  
 N25°W, 36.90' - iron & cap #24594  
 N32°E, 39.94' - 12" Elm, set nail & washer  
 S03°E, 28.30' - 10" Spruce, set nail & washer

Signed by Eugene Farrier  
 Michigan License No. 24594

Date 2-8-99

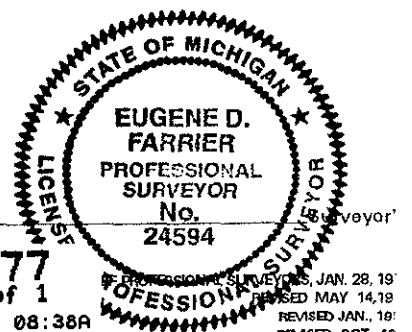

**3012677**  
 Page: 1 of 1  
 02/10/1999 08:38A