

LAND CORNER RECORDATION CERTIFICATE  
Filing Requirement of Act 74, Mich. P.A. 1970

MAR 01 2000

For corners in

KALKASKA  
(County)

Located In: Corner Code #

SECTION

1999 REMONUMENTATION  
1. Public Land Survey

T 25N R 8W K-7

2. Property Controlling  
in Section

S      T      R       
S      T      R     

3. Miscellaneous  
Property in Sec.

S      T      R       
S      T      R     



**3020140**  
Page: 1 of 1  
02/04/2000 03:19P  
REMON  
LB: 6 PG: 85

Register of Deeds Stamp & File Number

4. Lot No. \_\_\_\_\_, Recorded Plat \_\_\_\_\_

5. Private Claims \_\_\_\_\_

I, EUGENE FARRIER, in a field survey on November 2, 1999 do hereby state that under requirements of P.A. 74, Michigan P.A. of 1970, the corner points mentioned in lines 1 and 2 above were in conformance with regulations and rules therefore as required in the current manual of survey instructions of the United States Department of the Interior, Bureau of Land Management or by a decree of a Court of Law and for that the corner points mentioned in lines 3, 4 and 5 above were in conformance with the rules of the Michigan Board of Land Surveyors or by a Decree of a Court of Law; established, re-established, monumented, recovered, found as expressed below:

	A	B	C	D	E	F	G	H	I	J	K	L	M
1													
2		6		5		4		3		2		1	
3													
4		7		8		9		10		11		12	
5													
6		18		17		16		15		14		13	
7													
8		19		20		21		22		23		24	
9													
10		30		29		28		27		26		25	
11													
12		31		32		33		34		35		36	
13													

NOTE: Not more than 2 corners, all in the same town and range, may be recorded on this certificate.


A. Description of original monument and accessories and/or subsequent restoration:

K-7: Sec. Cor. Common to Sec. 13, 14, 23, & 24, T25N-R8W, Springfield Township  
1852, G.L.O. Resurvey, by V.W. Caukin (Deputy Surveyor) Co. Survey Notes Pg. 283, set post, Spruce 8", N30°W, 32 Lks ( 21.12'); Spruce 8", S73°E, 14 Lks. ( 9.24')  
1918, Survey, by W.S. Merrill (Co. Surveyor) Co. Survey Bk 24, Pgs. 1-3, visited corner, no accessories  
1993, LCRC & Survey, by J.D. Geers, (LCRC recorded in Liber 3, Pg. 13; Survey recorded in Liber 4, Pg. 145) reestablished NE corner of Section 23 by double proportion from North 1/2 corner of Section 23, Northeast corner of Section 24, East 1/4 corner of Section 23, and East 1/4 corner of Section 14, set iron & cap #33977, S11°W, 40.43', 14" R. Pine, S76°E, 37.65', 8" W. Pine; N15°E, 57.40', corner fence post; N09°W, 57.94', 10" Poplar, 10' +/- West of N-S fence; 23' +/- North of fence to East; 55' +/- South of fence to East.

B. Description of corner evidence found and/or method applied in restoring or reestablishing corner:

K-7: Sec. Cor. Common to Sec. 13, 14, 23, & 24, T25N-R8W, Springfield Township  
Found and accepted 1/2" rod w/cap #14102 inside of 5 gallon pail filled w/concrete 10' West of N-S fence & 55' South of fence to East.  
S11°W, 40.43', 14" R. Pine, found spike  
N09°W, 57.94', 10" Poplar, found spike  
N15°E, 57.40', corner fence post, found spike  
S76°E, 37.65', 8" W. Pine, found spike  
No G.L.O. witnesses were found.

Ratified by Peer Group  
P.A. 345 - 1990 Kalkaska County  
Chairman Eugene Farrier  
Date 02-03-00

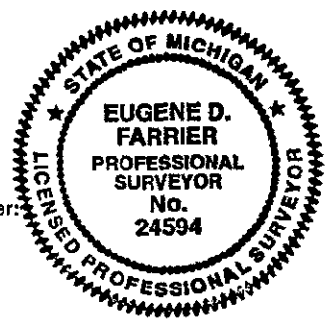

C. Description of monument for corner and accessories established to perpetuate locating the position of the corner:

K-7: Sec. Cor. Common to Sec. 13, 14, 23, & 24, T25N-R8W, Springfield Township  
Found and accepted 1/2" rod w/cap #14102 inside of 5 gallon pail filled w/concrete. Added aluminum cap.  
S11°W, 40.43', 14" R. Pine, found spike  
N09°W, 57.94', 10" Poplar, found spike  
N15°E, 57.40', corner fence post, found spike  
S76°E, 37.65', 8" W. Pine, found spike  
Kalkaska County Peer Group accepted the above monument as a careful and faithful reestablishment of the position of the original corner.

Signed by Eugene Farrier  
Michigan License No. 24594

Date 02-04-00 Surveyor's