

SURVEY & RECORDS

MAR 01 2000

LAND CORNER RECORDATION CERTIFICATE Filing Requirement of Act 74, Mich. P.A. 1970

For corners in

KALKASKA
(County)

Located In: Corner Code #

SECTION

1999 REMONUMENTATION
1. Public Land Survey

T 25N R 8W K-9

2. Property Controlling
in Section

S T R
S T R

3. Miscellaneous
Property in Sec.

S T R
S T R



3020142
Page: 1 of 1
02/04/2000 03:40P
REMON
LB: 6 PG: 88

Register of Deeds Stamp & File Number

4. Lot No. _____, Recorded Plat _____

5. Private Claims _____

I, EUGENE FARRIER, in a field survey on November 17, 1999 do hereby state that under requirements of P.A. 74, Michigan P.A. of 1970, the corner points mentioned in lines 1 and 2 above were in conformance with regulations and rules therefore as required in the current manual of survey instructions of the United States Department of the Interior, Bureau of Land Management or by a decree of a Court of Law and /or that the corner points mentioned in lines 3, 4 and 5 above were in conformance with the rules of the Michigan Board of Land Surveyors or by a Decree of a Court of Law; established, re-established, monumented, recovered, found as expressed below:

	A	B	C	D	E	F	G	H	I	J	K	L	M
1													
2	6		5		4		3		2		1		
3													
4	7		8		9		10		11		12		
5													
6	18		17		16		15		14		13		
7													
8	19		20		21		22		23		24		
9													
10	30		29		28		27		26		25		
11													
12	31		32		33		34		35		36		
13													

NOTE: Not more than 2 corners, all in the same town and range, may be recorded on this certificate.


A. Description of original monument and accessories and/or subsequent restoration:

K-9: Sec. Cor. Common to Sec. 23, 24, 25 & 26, T25N-R8W, Springfield Township
 1852, G.L.O. Resurvey, by V.W. Caukin (Deputy Surveyor) Co. Survey Notes Pg 285, set post, Sugar 29", S42°W, 6 Lks; Sugar 20", S24°W, 9 Lks
 1912, Survey, by Fargo, found stake & roots of both U.S. witnesses set in roads, set 3/4" iron pipe.
 1922, Sec. Subd. Survey, by W.S. Merrill (Co. Surveyor) Co. Survey Bk 33, Pg 101, Pine 30", N53°W, 54 Lks iron pipe
 1973, Survey & LCRC, by J.L. Wilcox, (Survey recorded in Liber 1, Pg 284; LCRC recorded in Liber 1, Pg. 194) found 3/4" pipe 1.5' below road surface, raised w/ 1/2" rod, N27°W, 12" Bass, 61.50'; N57°E, 5" Maple, 67.92'; S44°E, 12" Oak, 68.26'
 1973, Survey & LCRC, by D.Verba, (Survey recorded in Liber 1, Pg 288 & 289; LCRC recorded in Liber 1, Pg 276) found iron pipe w/RLS cap #14102 at road intersection, found nail SE side 5" Maple Az 56°, 68.00'; found nail East side 12" Maple, Az 139°, 68.33'; found nail NE side 12" Ash, Az 331°, 61.55'
 1981, LCRC, by P. Stout, recorded in Liber 2, Pg 221, found 3/4" iron pipe & cap, 12" Basswood, N30°W, 81.53'; 7" Maple, N57°E, 67.90'; 10" Oak, S40°E, 68.26'
 1984, Survey, by E. Farrier (Co. Surveyor) found RLS cap #14102, wit. same as Verba (1973- Liber 1, Pg 289)

B. Description of corner evidence found and/or method applied in restoring or reestablishing corner:

K-9: Sec. Cor. Common to Sec. 23, 24, 25 & 26, T25N-R8W, Springfield Township
 Found 1/2" rod & cap #14102, 1' South of centerline E-W road & 6' East of road to North.
 N12°E, 70.38', 10" Maple in clump, set nail & washer
 N55°E, 67.97', 12" Maple, found spike
 S58°E, 49.78', power pole, set nail & washer
 N33°W, 61.50', 14" Maple, found spike
 No G.L.O. witnesses were found.

Ratified by Peer Group
 P.A. 345 - 1990 Kalkaska County
 Chairman Eugene Farrier
 Date 02-03-00

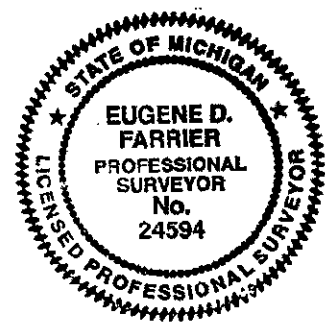

C. Description of monument for corner and accessories established to perpetuate locating the position of the corner:

K-9: Sec. Cor. Common to Sec. 23, 24, 25 & 26, T25N-R8W, Springfield Township
 Found 1/2" rod & cap #14102, 1' South of centerline E-W road & 6' East of road to North. Pulled & set 5/8" X 18" rerod & brass cap in mon. box.
 N12°E, 70.38', 10" Maple in clump, set nail & washer
 N55°E, 67.97', 12" Maple, found spike
 S58°E, 49.78', power pole, set nail & washer
 N33°W, 61.50', 14" Maple, found spike
 Kalkaska County Peer Group accepted the above monument as a careful and faithful perpetuation evidence of the position of the original corner.

Signed by Eugene Farrier
 Michigan License No. 24594

Date 02-04-00 Surveyor's