

SURVEY & REMONUMENTATION

FEB 13 1998

LAND CORNER RECORDATION CERTIFICATE Filing Requirement of Act 74, Mich. P.A. 1970

SECTION

For corners in

<u>KALKASKA</u>	Located In:	Corner Code #
(County)		
1997 REMONUMENTATION	T <u>26N</u> R <u>8W</u>	<u>L-13</u>
1. Public Land Survey	T <u>25N</u> R <u>8W</u>	<u>L-1</u>
	T ___ R ___	_____
	T ___ R ___	_____
2. Property Controlling	S ___ T ___ R ___	_____
in Section	S ___ T ___ R ___	_____
3. Miscellaneous	S ___ T ___ R ___	_____
Property in Sec.	S ___ T ___ R ___	_____

Register of Deeds Stamp & File Number

4. Lot No. _____, Recorded Plat _____

5. Private Claims _____

I, EUGENE FARRIER, in a field survey on SEPTEMBER 30, 1997, do hereby state that under requirements of P.A. 74, Michigan P.A. of 1970, the corner points mentioned in lines 1 and 2 above were in conformance with regulations and rules therefore as required in the current manual of survey instructions of the United States Department of the Interior, Bureau of Land Management or by a decree of a Court of Law and /or that the corner points mentioned in lines 3, 4 and 5 above were in conformance with the rules of the Michigan Board of Land Surveyors or by a Decree of a Court of Law; established, re-established, monumented, recovered, found as expressed below:

NOTE: Not more than 2 corners, all in the same town and range, may be recorded on this certificate.


	A	B	C	D	E	F	G	H	I	J	K	L	M
1													
2	6		5		4		3		2		1		
3													
4	7		8		9		10		11		12		
5													
6	18		17		16		15		14		13		
7													
8	19		20		21		22		23		24		
9													
10	30		29		28		27		26		25		
11													
12	31		32		33		34		35		36		
13													

A. Description of original monument and accessories and/or subsequent restoration:
L-13: S 1/4 Cor. Sec. 36, T26N-R8W, Boardman Township, & N 1/4 Cor. Sec. 1, T25N-R8W, Springfield Township.
 1852, GLO resurvey, set post, 6" Beech, N80W 29, 6" Beech, N20E 11
 July 1911, W.S. Merrill, fd. Iron w/accessories
 August 1973, J.L. Wilcox #14102, LCR, fd. 2" iron pipe w/accessories, Lib. 1, Pg. 257
 09-08-1992, Grand Traverse Surveying Co., Cert. Survey, fd. 2" iron pipe, raised w/1/2" rod & cap #28432 w/accessories
 08-08-1993, Farrier Surveying, Cert. Survey, fd. 1/2" iron & cap #28432 w/accessories

B. Description of corner evidence found and/or method applied in restoring or reestablishing corner:
L-13: S 1/4 Cor. Sec. 36, T26N-R8W, Boardman Township & N 1/4 Cor. Sec. 1, T25N-R8W, Springfield Township.
 Fd. 1/2" iron & cap #28432 in C/L of Inman Rd. Pulled and replaced with 5/8" x 18" rebar, w/brass cap. No GLO witnesses found. The Kalkaska Co. Peer group approved and accepted as the best available evidence of the position of the original corner.

C. Description of monument for corner and accessories established to perpetuate locating the position of the corner:
L-13: S 1/4 Cor. Sec. 36, T26N-R8W, Boardman Township & N 1/4 Cor. Sec. 1, T25N-R8W, Springfield Township.
 Fd. 1/2" iron & cap #28432 in C/L of Inman Rd. Pulled and replaced with 5/8" x 18" rebar, w/brass cap.
 Fd. Nail N17E, 8" Tw. Maple 22.16'
 Fd. Nail N47W, 16" Maple 35.70'
 Fd. Nail South, P. Pole 20.96'
 Fd. Nail S42W, 8" Maple 49.60'

Ratified by Peer Group
P.A. 345 - 1990 Kalkaska County
 Chairman Eugene Farrier
 Date 1-29-98

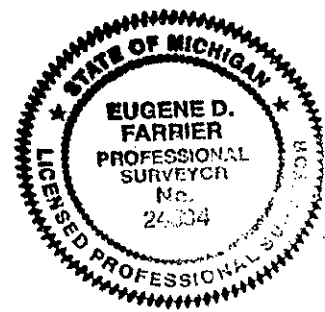

Signed by Eugene Farrier
 Surveyor's Michigan License No. 24594

Date 2-3-98