

**LAND CORNER RECORDATION CERTIFICATE**  
**Filing Requirement of Act 74, Mich. P.A. 1970**

For corners in

SURVEY &  
 RECORDATION

KALKASKA  
 (County)

Located In: Corner Code #

MAR 01 2000

1999 REMONUMENTATION

1. Public Land Survey

T 25N R 8W

M-8

T 25N R 7W

A-8

T \_\_\_\_\_ R \_\_\_\_\_

T \_\_\_\_\_ R \_\_\_\_\_

2. Property Controlling  
 in Section

S \_\_\_\_\_ T \_\_\_\_\_ R \_\_\_\_\_

S \_\_\_\_\_ T \_\_\_\_\_ R \_\_\_\_\_

3. Miscellaneous  
 Property in Sec.

S \_\_\_\_\_ T \_\_\_\_\_ R \_\_\_\_\_

S \_\_\_\_\_ T \_\_\_\_\_ R \_\_\_\_\_

Kalkaska County Joan Hall, Register

**3020147**  
 Page: 1 of 1  
 02/04/2000 03:40P  
 REMON  
 LB: 5 PG: 93

Register of Deeds Stamp & File Number

4. Lot No. \_\_\_\_\_, Recorded Plat \_\_\_\_\_

5. Private Claims \_\_\_\_\_

	A	B	C	D	E	F	G	H	I	J	K	L	M
1													
2	6		5		4		3		2		1		
3													
4	7		8		9		10		11		12		
5													
6	18		17		16		15		14		13		
7													
8	19		20		21		22		23		24		
9													
10	30		29		28		27		26		25		
11													
12	31		32		33		34		35		36		
13													

I, EUGENE FARRIER, in a field survey on November 9, 1999 do hereby state that under requirements of P.A. 74, Michigan P.A. of 1970, the corner points mentioned in lines 1 and 2 above were in conformance with regulations and rules therefore as required in the current manual of survey instructions of the United States Department of the Interior, Bureau of Land Management or by a decree of a Court of Law and /or that the corner points mentioned in lines 3, 4 and 5 above were in conformance with the rules of the Michigan Board of Land Surveyors or by a Decree of a Court of Law; established, re-established, monumented, recovered, found as expressed below:

**NOTE: Not more than 2 corners, all in the same town and range, may be recorded on this certificate.**

A. Description of original monument and accessories and/or subsequent restoration:  
M-8: 1/4 Cor. Common to Sec. 24, T25N-R8W, Springfield Township; A-8: Sec. 19, T25N-R7W, Garfield Township


1852, G.L.O. Resurvey, by V.W. Caukin (Deputy Surveyor) Co. Survey Notes Pg 272 & 273, set 1/4 Section post, Beech 8", N48°W, 36 Lks; Birch 18", S37°W, 49 Lks  
 1972, LCRC, by J.L. Wilcox, recorded in Liber 1, Pg 7, set 1/2" iron by proportionate distances & in centerline of road & also centerline of road fences; due East top of corner post, 33.09'; due West corner fence post, 36.43'; S30°W, power pole, 120.00'

B. Description of corner evidence found and/or method applied in restoring or reestablishing corner:

M-8: 1/4 Cor. Common to Sec. 24, T25N-R8W, Springfield Township; A-8: Sec. 19, T25N-R7W, Garfield Township

Found 1/2" iron & cap #14102, 1' West of centerline N-S road on fence to East.  
 N35°E, 70.37', 3" R. Pine, set nail & washer  
 N65°E, 34.62', 4" Apple tree, set nail & washer  
 East, 33.48', corner fence post, set nail & washer  
 S20°W, 120.04', power pole, set nail & washer  
 No G.L.O. witnesses were found.

Ratified by Peer Group  
 P.A. 345 - 1990 Kalkaska County  
 Chairman Eugene Farrier  
 Date 02-03-00

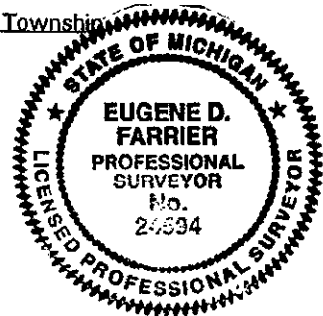

C. Description of monument for corner and accessories established to perpetuate locating the position of the corner:

M-8: 1/4 Cor. Common to Sec. 24, T25N-R8W, Springfield Township; A-8: Sec. 19, T25N-R7W, Garfield Township

Found 1/2" iron & cap #14102, 1' West of centerline N-S road on fence to East. Pulled & set 5/8" X 18" rerod w/ brass cap in mon. box.  
 N35°E, 70.37', 3" R. Pine, set nail & washer  
 N65°E, 34.62', 4" Apple tree, set nail & washer  
 East, 33.48', corner fence post, set nail & washer  
 S20°W, 120.04', power pole, set nail & washer  
 Kalkaska County Peer Group accepted the above monument as a careful and faithful reestablishment of the position of the original corner.

Signed by Eugene Farrier  
 Michigan License No. 24594

Date 02-04-00 Surveyor's