

MICHIGAN  
DEPARTMENT OF CONSERVATION  
FORESTRY DIVISION

LAND CORNER RECORD

T. 26 NR. 5 W.

Kalkaska COUNTY

DESCRIPTION OF CORNER 1/4 corner common to Sections 20 & 21

DESCRIPTION OF CORNER MONUMENT 1" pipe with 4" brass cap


WITNESSES TO CORNER Double 12" R. Pine - N28E - 95 links

8" Spruce - N60W - 39 links

DESCRIPTION IN DETAIL AS TO HOW CORNER WAS LOCATED AND IDENTIFIED OR RESTORED.

This corner was found by forestry division survey crew while making a partial resurvey of this township. Found remains of very old scribed post set from probable original BTs. Both BTs in place but badly rotted. Corner conforms with original corner north and south.

Corner was plced and witnessed Oct. 3, 1955.

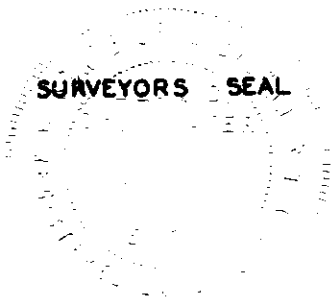

SIGNED Jean C. [Signature] DATE 3/12/56  
REGISTERED LAND SURVEYOR