

MICHIGAN
DEPARTMENT OF CONSERVATION
FORESTRY DIVISION

LAND CORNER RECORD

T. 26 NR. 5 W. . .

Kalkaska COUNTY

DESCRIPTION OF CORNER Corner common to Sections 16, 17, 20, 21

DESCRIPTION OF CORNER MONUMENT 1" pipe with 4" brass cap


WITNESSES TO CORNER 6" J. Pine - S85E - 31 1/2 links

6" J. Pine - N40W - 13 links

DESCRIPTION IN DETAIL AS TO HOW CORNER WAS LOCATED AND IDENTIFIED OR RESTORED.

This corner was established by Forestry Division survey crew while making a partial resurvey of this township. SE original BT stump in place, but badly burned.

Co ner was placed and witnessed June 9, 1955.

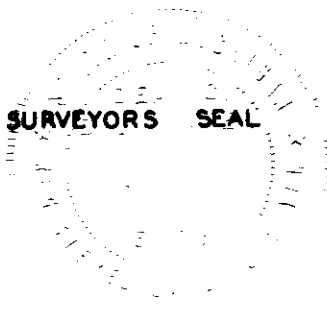

SIGNED John C. [Signature]
REGISTERED LAND SURVEYOR

DATE 3/12/56