

MICHIGAN
DEPARTMENT OF CONSERVATION
FORESTRY DIVISION

LAND CORNER RECORD

T. 26. NR. 5. W. . .

Kalkaska COUNTY

DESCRIPTION OF CORNER Corner common to Sections 8, 9, 16, 17

DESCRIPTION OF CORNER MONUMENT 1" pipe with 4" brass cap


WITNESSES TO CORNER 10" B. Oak - S53E - 82½ links

10" Cherry - S43W - 87½ links

DESCRIPTION IN DETAIL AS TO HOW CORNER WAS LOCATED AND IDENTIFIED OR RESTORED.

This corner was found by Forestry Division survey crew while making a partial resurvey of this township. Both original BT stumps in place, the SW with evidence of face.

Corner was placed and witnessed June 8, 1955.

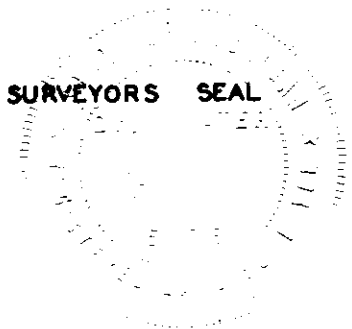

SIGNED *Dean C. [Signature]* DATE 3/8/56
REGISTERED LAND SURVEYOR