

ENG DIVISION

LAND CORNER RECORDATION CERTIFICATE

FILING REQUIREMENT OF ACT 74, MICH. P.A.1970

FOR CORNERS OF --:	LOCATED IN --:	CORNER CODE NUMBER
1. PUBLIC LAND SURVEY _____	T. <u>26</u> N. R. <u>5</u> W.	G-3; H-3; I-3
2. PROPERTY CONTROLLING IN SECTION <u>3</u>	T. <u>26</u> N. R. <u>5</u> W.	15
3. MISCELLANEOUS PROPERTY IN SECTION _____	T. _____ N. S. R. _____ E. W.	
4. LOT NO. _____, RECORDED PLAT _____		
5. PRIVATE CLAIMS _____		

REGISTER OF DEEDS STAMP AND FILING NUMBER

I, Kenneth J. Ostling, do hereby certify that under requirements of P.A. 74, Michigan P.A. of 1970, the corner points mentioned in lines 1 and 2 above were, in a field survey on June 7, 1979, established, re-established, monumented, re-monumented, recovered or restored as expressed below and in conformance with regulations and rules therefore as required in the current manual of survey instructions of the United States Department of the Interior, Bureau of Land Management or by a decree of a court of law. Furthermore, that the corner points mentioned in lines 3, 4 and 5 above were, in a field survey on _____, 19____, found, recovered, restored, established or re-established as expressed below and in conformance with the rules of the Michigan State Board of Registration for Land Surveyors or, by a Decree of a Court of law:

A. - ~~Description of original monument and accessories and/or subsequent restoration:~~

C. (continued)

15

Set 5/8" Rod & Cedar Post
 10" W. Birch S78°W 12.8
 9" Tamarack N11°E 5.45


B. Description of corner evidence found and/or method applied in restoring or re-establishing corner:

- G-3 Set corner from record of Houghton witnesses. Falls at fence corner N-S-E. Apparently used in previous attempt to subdivide.
 - H-3 Set corner by proportionate measurement, midpoint on line, between section corners. No evidence of previous corner.
 - I-3 Found 1½" pipe on SE corner of power line R-O-W which apparently was used in adjacent surveys in Section 2.
 - 15 Set corner by standard survey procedure for the subdivision of sections.
- C. Description of monument for corner and accessories established to perpetuate locating the position of the corner:

G-3	H-3	I-3
Set DNR Mon. & Cedar Post	Set DNR Mon. & Cedar Post	Left 1½" pipe in place
8" W. Birch in clump	18" R. Pine S16°W 29.25	20" W. Pine S02°W 75.9
N44°E 14.1	4" W. Pine N62°E 12.6	18" W. Pine N63°E 79.7
12" Oak S25°E 2.35	3" W. Pine N78°W 8.3	P.P. N60°W 35.88
16" W. Pine Stp.		Set Cedar Post
(Old NBT) S31°W 23.9		

SIGNED BY Kenneth J. Ostling SURVEYOR'S MICHIGAN REGISTRATION NO. 10068

DATE 7/7/79

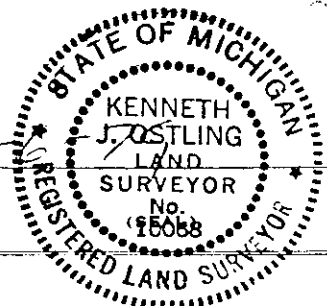

FOR STATE AND UNITED STATES AGENCIES.

SIGNED BY _____ DATE _____

CHIEF OF SURVEY PARTY

APPROVED AND SIGNED BY _____ DATE _____

MICHIGAN REGISTERED LAND SURVEYOR

(SEAL)

SURVEYOR'S MICHIGAN REGISTRATION NO. _____

KALKASKA COUNTY