

# LAND CORNER RECORDATION CERTIFICATE

Filing Requirement of Act 74, Mich. PA 1970

For Corners In:  
Kalkaska Located In \_\_\_\_\_ Corner Code # \_\_\_\_\_  
 (County)

- |                                      |   |            |   |           |           |
|--------------------------------------|---|------------|---|-----------|-----------|
| 1. Public Land Survey                | T | <u>26N</u> | R | <u>5W</u> | <u>C8</u> |
|                                      | T | _____      | R | _____     | _____     |
| 2. Property Controlling in Section   | S | _____      | T | _____     | R         |
|                                      | S | _____      | T | _____     | R         |
| 3. Miscellaneous Property in Section | S | _____      | T | _____     | R         |
|                                      | S | _____      | T | _____     | R         |

4. Lot No: \_\_\_\_\_ Recorded Plat: \_\_\_\_\_

5. Private Claims: \_\_\_\_\_

I, Craig W. McVean, in a field survey on Feb. 17, 2009 do hereby state that under requirements of PA 74, Michigan PA of 1970, the corner points mentioned in lines 1 and 2 above were in conformance with regulations and rules therefore as required in the current manual of survey instructions of the United States Department of the Interior, Bureau of Land Management or by a decree of a Court of Law and/or that the corner points mentioned in lines 3, 4 and 5 above were in conformance with the rules of the Michigan Board of Land Surveyors or by a Decree of a Court of Law; established, re-established, monumented, recovered, found as expressed below:

**NOTE: Not more than 2 corners, all in the same town and range, may be recorded on this certificate.**

A. Description of original monument and accessories and/or subsequent restoration:



- C8 – 1852 – GLO – G. Cannon – Set ¼ Post  
 1) Cedar 18" N55°E 18 L.  
 2) Cedar 12" S70°W 31 L.  
 - 1956 – DNR Corner record – B. D. Buckley – Both original BT stamps in place with evidence of face on one. Found very old stake point in muck below surface while searching for corner. Set 1" pipe with 4" Brass Cap; 3) 6" Cedar N51°E 18 L.; 4) 5" Cedar N31°W 25 L.

B. Description of corner evidence found and/or method applied in restoring or re-establishing corner:

- C8 – ¼ Corner common to Sec. 19 & 20 – Fd. 4" DOC (DNR) Brass Cap Monument in cedar swamp per Buckler. Fd. remains of Witnesses 1 & 2, Witnesses #3 is good and #4 is dead. 4" DOC Mon. accepted as a careful and faithful perpetuation of the position of the original corner.

C. Description of monument for corner and accessories established to perpetuate locating the position of the corner:

- C8 – 4" DOC (DNR) Brass Cap on 1" iron pipe  
 Set Blue Carsonite Post 1' East  
 N51°E 11.62' to set N & T in NW side 10" Cedar (#3)  
 N71°E 18.73' to set N & T at fd. nail in N. side 14" Tamarack  
 North 6.90' to set N & T at fd. nail in W. side 8" Cedar  
 S45°E 22.82' to set N & T at fd. nail in NE side 5" Cedar  
 S47°W 22.04' to set N & T in NW side 7" Cedar scribed 'XBT'

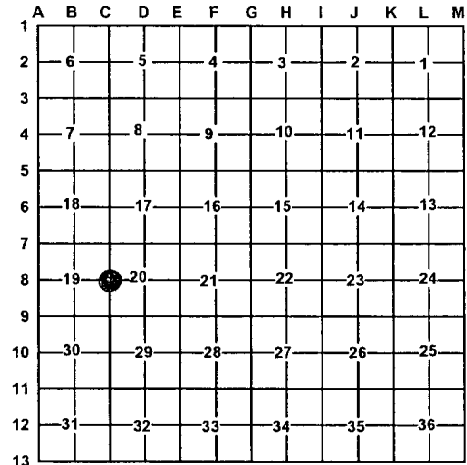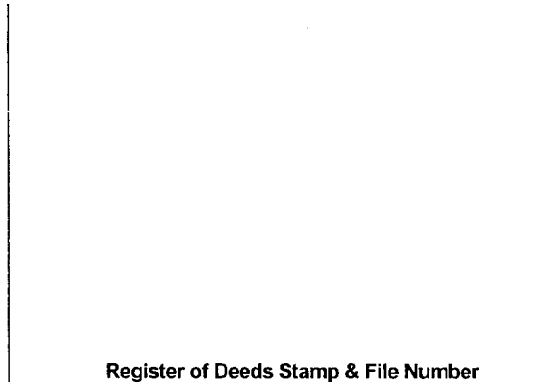

Signed by: Craig W. McVean  
 Surveyor's Michigan License No.: 39088

Date: 11/23/2009