92

# LAND CORNER RECORDATION CERTIFICATE

**Filing Requirement of Act 74, Mich. P.A. 1970**

For corners in KALKASKA (County)

| | Located In: | Corner Code ## |
|---|---|---|
| 1. Public Land Survey | T 25N R 6W | L-6, M-5 |
| | T ___ R ___ | M-6 |
| | T ___ R ___ | |
| | T ___ R ___ | |
| 2. Property Controlling | S 13 T ___ R ___ | 9 |
| in Section | S ___ T ___ R ___ | |
| 3. Miscellaneous | S ___ T ___ R ___ | |
| Property in Sec. | S ___ T ___ R ___ | |

Register of Deeds Stamp & File Number

4. Lot No. _____ , Recorded Plat _____
5. Private Claims _____

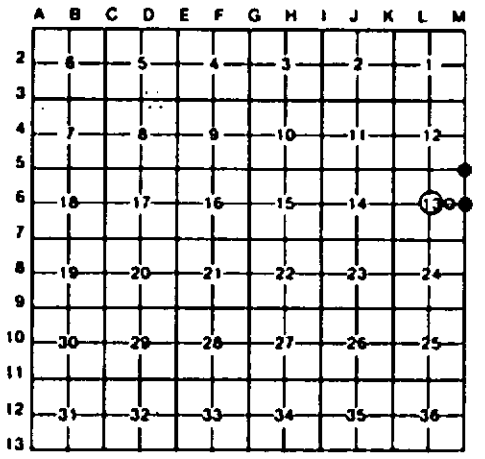


I, C.T.KIISKILA, in a field survey on FEB. 2, 19 95, do hereby certify that under requirements of P.A. 74, Michigan P.A. of 1970, the corner points mentioned in lines 1 and 2 above were in conformance with regulations and rules therefore as required in the current manual of survey instructions of the United States Department of the Interior, Bureau of Land Management or by a decree of a Court of Law and/or that the corner points mentioned in lines 3, 4 and 5 above were in conformance with the rules of the Michigan Board of Land Surveyors or by a Decree of a Court of Law; established, re-established, monumented, re-monumented, recovered, found as expressed below:

**NOTE: Not more than 4 corners, all in the same town and range, may be recorded on this certificate.**

A. Description of original monument and accessories and/or subsequent restoration:

L-6 M-5 M-6 9

(NO EVIDENCE OF G.L.O. CORNER, B.T'S, LINE TREES & TOPOGRAPHY, AS CALLED OUT IN THE G.L.O. LINE NOTES; UNLESS NOTED IN ITEM "B" BELOW.)

B. CONT)-- & SMALL SIDE NAILS ON WIT TREES WE USED TO NW & NE AND ALSO ON TWO OTHER TREES WE DID NOT USE.

STATE OF MICHIGAN
CARL KIISKILA
LAND SURVEYOR
No. 33981
LICENSED LAND SURVEYOR

B. Description of corner evidence found and/or method applied in restoring or reestablishing corner:

**L-6**
ESTABLISHED CTR OF SEC 13 AT INTERSECTION OF 1/4 LINES.

**M-5**
FD M.SCHAAF MON IN CTR OF N-S TRAIL AS SET IN 1940 DEPT SURVEY FROM ORIGINAL BT'S. FD 1955 CONS DEPT MON (1"x 42" PIPE & CAP) LYING ON GROUND WEST OF TRAIL, DUG DOWN ON W. SIDE OF M.S. MON & FD HOLE OF 1" PIPE'S ORIGINAL POSITION & RESET SAME. W.OAK 561 E AS NOTED BY M.S. IS U.S. GOVT WIT. FD NEWER UPPER BLAZES & SMALL SIDE NAILS ---CONT ABOVE

**M-6**
ESTABLISHED E1/4 COR OF SEC 13 MIDWAY AND ON LINE BETWEEN FD SEC CORNERS 1/2 MILE N & S. CORNER FITS US TIE TO SWAMP EDGE TO N, REASONABLE (US = 1 CHAIN TO SWP EDGE, WE MEAS 30'± 4').

**9**
ESTABLISHED NE COR OF NW1/4 OF SE1/4 OF SEC 13 PER STANDARD BLM INSTRUCTIONS. CTR OF 4' WIDE STREAM (COURSE W'LY) IS 23' N & 18' E. CTR OF TRAIL RD NE-SW, AT CULVERT IS WEST 320'±.

C. Description of monument for corner and accessories established to perpetuate locating the position of the corner:

**L-6**
DROVE 5/8"x 34" REROD W/PS CAP & SET CEDAR POST W/LOC TAG.

| | | |
|---|---|---|
| 18" W.PINE | N80°W | 29.7' |
| 9" R.PINE | N50°E | 28.1' |
| 11" R.PINE | S80°E | 34.0' |
| 5" W.PINE | S35°W | 34.9' |

**M-5**
FD CONSV DEPT BRASS CAP ON 1"x 42" GALV PIPE ON W. SIDE OF 1 1/2" SHORT PIPE IN CONC BLOCK.

| | | |
|---|---|---|
| #11" B.OAK | N27°W | 29.90' |
| #14" B.OAK | N74°E | 9.48' |
| 18" W.OAK | S61°E | 13.08' |
| 7"TW.B.OAK | S45°W | 14.45' |
| 30"W.PINE STP | N56°E | 24.3' |
| SET CEDAR POST WITH LOC. TAG | WEST | 20' |

**M-6**
DROVE 1"x 72" GALV PIPE W/ALUMN CAP, & SET CEDAR POST.

| | | |
|---|---|---|
| 5" TAMARACK | N60°W | 25.0' |
| 12" CEDAR | N50°E | 26.1' |
| 16" CEDAR | S45°E | 34.8' |
| 10" CEDAR | S70°W | 16.7' |

**9**
DROVE 1"x 72" GALV. PIPE W/PS CAP & SET CED POST W/LOC TAG.

| | | |
|---|---|---|
| 8" CEDAR | NORTH | 12.5' |
| 6" CEDAR | S80°E | 12.9' |
| 8" CEDAR | SOUTH | 11.1' |
| 8" CEDAR | N65°W | 21.5' |

Signed by Carl T. Kiiskila Date 2-2-95

Surveyor's Michigan License No. 33981

FORM APPROVED BY MICHIGAN STATE BOARD OF LAND SURVEYORS, JAN. 28, 1971
REVISED MAY 14, 1975
REVISED JAN. 1983