

LAND CORNER RECORDATION CERTIFICATE
Filing Requirement of Act 74, Mich. P.A. 1970

For corners in
KALKASKA
 (County)

Located In: _____ Corner Code 11

- | | | |
|------------------------------------|-----------------------------|-----------------|
| 1. Public Land Survey | T <u>25N</u> R <u>6W</u> | <u>L-6, M-5</u> |
| | T _____ R _____ | <u>M-6</u> |
| | T _____ R _____ | _____ |
| | T _____ R _____ | _____ |
| 2. Property Controlling in Section | S <u>13</u> T _____ R _____ | <u>9</u> |
| | S _____ T _____ R _____ | _____ |
| 3. Miscellaneous Property in Sec. | S _____ T _____ R _____ | _____ |
| | S _____ T _____ R _____ | _____ |

Register of Deeds Stamp & File Number

4. Lot No. _____, Recorded Plat _____
 5. Private Claims _____

A	B	C	D	E	F	G	H	I	J	K	L
2	6	5	4	3	2	1					
3											
4	7	8	9	10	11	12					
5											
6	18	17	16	15	14	13					
7											
8	19	20	21	22	23	24					
9											
10	30	29	28	27	26	25					
11											
12	31	32	33	34	35	36					
13											


I, C.T. KIISKILA, in a field survey on FEB. 2, 19 95, do hereby certify that under requirements of P.A. 74, Michigan P.A. of 1970, the corner points mentioned in lines 1 and 2 above were in conformance with regulations and rules therefore as required in the current manual of survey instructions of the United States Department of the Interior, Bureau of Land Management or by a decree of a Court of Law and/or that the corner points mentioned in lines 3, 4 and 5 above were in conformance with the rules of the Michigan Board of Land Surveyors or by a Decree of a Court of Law; established, re-established, monumented, re-monumented, recovered, found as expressed below:

NOTE: Not more than 4 corners, all in the same town and range, may be recorded on this certificate.

A. Description of original monument and accessories and/or subsequent restoration:
 L-6 M-5 M-6

(NO EVIDENCE OF G.L.O. CORNER, B.T.'S, LINE TREES & TOPOGRAPHY, AS CALLED OUT IN THE G.L.O. LINE NOTES; UNLESS NOTED IN ITEM "B" BELOW.)

B. CONT-- & SMALL SIDE NAILS ON MIT TREES WE USED TO NW & NE AND ALSO ON TWO OTHER TREES WE DID NOT USE.

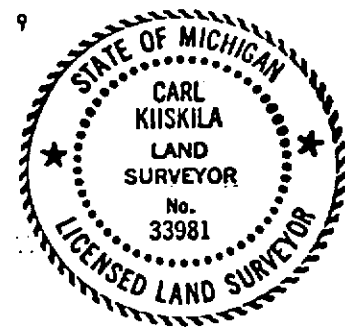

B. Description of corner evidence found and/or method applied in restoring or reestablishing corner:

- | | | | |
|--|--|--|--|
| L-6
ESTABLISHED CTR OF SEC 13 AT INTERSECTION OF 1/4 LINES. | M-5
FD M.SCHAAF MON IN CTR OF N-S TRAIL AS SET IN 1940 DEPT SURVEY FROM ORIGINAL BT'S. FD 1955 CONS DEPT MON (1"x 42" PIPE & CAP) LYING ON GROUND WEST OF TRAIL, DUG DOWN ON W. SIDE OF M.S. MON & FD HOLE OF 1" PIPE'S ORIGINAL POSITION & RESET SAME. W.OAK 561 E AS NOTED BY M.S. IS U.S. GOVT MIT. FD NEWER UPPER BLAZES & SMALL SIDE NAILS ---CONT ABOVE | M-6
ESTABLISHED E 1/4 COR OF SEC 13 MIDWAY AND ON LINE BETWEEN FD SEC CORNERS 1/2 MILE N & S. CORNER FITS US TIE TO SWAMP EDGE TO N, REASONABLE (US = 1 CHAIN TO SWP EDGE, WE MEAS 30' ± 4'). | 9
ESTABLISHED NE COR OF NW 1/4 OF SE 1/4 OF SEC 13 PER STANDARD BLM INSTRUCTIONS. CTR OF 4' WIDE STREAM (COURSE W'LY) IS 23' N & 18' E. CTR OF TRAIL RD NE-SW, AT CULVERT IS WEST 320' ±. |
|--|--|--|--|

C. Description of monument for corner and accessories established to perpetuate locating the position of the corner:

- | | | | |
|---|---|---|--|
| L-6
DROVE 5/8" x 3/4" REROD W/PS CAP & SET CEDAR POST W/LOC TAG.
18" W.PINE N80°W 29.7'
9" R.PINE N50°E 28.1'
11" R.PINE S80°E 34.0'
5" W.PINE S35°W 34.9' | M-5
FD CONSV DEPT BRASS CAP ON 1"x 42" GALV PIPE ON W. SIDE OF 1 1/2" SHORT PIPE IN CONC BLOCK.
#11" B.OAK N27°W 29.90'
#14" B.OAK N74°E 9.48'
18" W.OAK S61°E 13.08'
7" TW. B.OAK S45°W 14.45'
30" W.PINE STP N56°E 24.3'
SET CEDAR POST WITH LOC. TAG WEST 20' | M-6
DROVE 1"x 72" GALV PIPE W/ALUMN CAP, & SET CEDAR POST.
5" TAMARACK N60°W 25.0'
12" CEDAR N50°E 26.1'
16" CEDAR S45°E 34.8'
10" CEDAR S70°W 16.7' | 9
DROVE 1"x 72" GALV. PIPE W/PS CAP & SET CED POST W/LOC TAG.
8" CEDAR NORTH 12.5'
6" CEDAR S80°E 12.9'
8" CEDAR SOUTH 11.1'
8" CEDAR N65°W 21.5' |
|---|---|---|--|

Signed by Carl T. Kiiskila Date 2-2-95
 Surveyor's Michigan License No. 33981