



8 0 2 3 2 8 2
Tx:4016447
11/29/2012 1:00:00 PM

LAND CORNER RECORDATION CERTIFICATE

Filing Requirement of Act 74, Mich. PA 1970


For Corners In: Kalkaska (County)	Located In		Corner Code #
1. Public Land Survey	T _____	R _____	_____
	T _____	R _____	_____
2. Property Controlling in Section	S <u>20</u>	T <u>26N</u> R <u>6W</u>	<u>14</u>
	S <u>20</u>	T <u>26N</u> R <u>6W</u>	<u>16</u>
3. Miscellaneous Property in Section	S _____	T _____ R _____	_____
	S _____	T _____ R _____	_____

DOCUMENT #
3111424
IOANN DEGRAAF
KALKASKA CTY ROD
KALKASKA, MI
RECORDED ON
11/29/2012 1:31 PM
REC FEE: 14.00
PAGES: 1
BK: 3PG: 348

Register of Deeds Stamp & File Number

4. Lot No: _____ Recorded Plat: _____
5. Private Claims: _____

I, Joshua R. Davidson, in a field survey on February 15, 2012 do hereby state that under requirements of PA 74, Michigan PA of 1970, the corner points mentioned in lines 1 and 2 above were in conformance with regulations and rules therefore as required in the current manual of survey instructions of the United States Department of the Interior, Bureau of Land Management or by a decree of a Court of Law and/or that the corner points mentioned in lines 3, 4 and 5 above were in conformance with the rules of the Michigan Board of Land Surveyors or by a Decree of a Court of Law; established, re-established, monumented, recovered, found as expressed below:

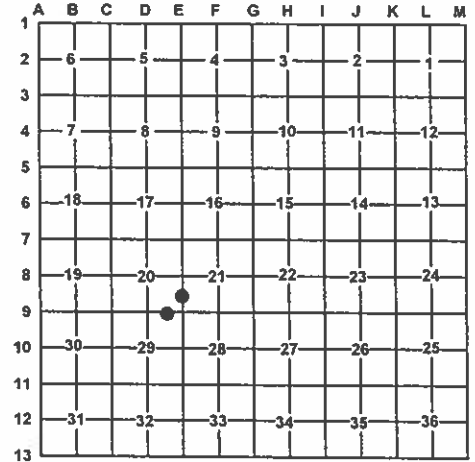

NOTE: Not more than 2 corners, all in the same town and range, may be recorded on this certificate.

A. Description of original monument and accessories and/or subsequent restoration:

14 - none 16 - none



B. Description of corner evidence found and/or method applied in restoring or re-establishing corner:

14 – South 1/16 corner common to sections 20 & 21. Set stamped 2" Aluminum cap on 5/8" x 48" rebar per standard BLM procedure. 16 – East 1/16 corner common to Sections 20 & 29. Set stamped 2" Aluminum cap on 5/8" x 48" rebar per standard BLM procedure.

C. Description of monument for corner and accessories established to perpetuate locating the position of the corner:

14 – Set a stamped 2" Aluminum Cap on 5/8" x 48" rebar
East 40.74' to set nail & tag in S. side 17" White Pine
S02°E 65.92' to set nail & tag in E. side 5" White Pine
S30°W 44.25' to set nail & tag in SE. side 7" Tamarack
N07°W 40.68' to set nail & tag in E. side 9" Jack Pine
Set blue Carsonite post with location tag 1' Northeast

16 – Set a stamped 2" Aluminum Cap on 5/8" x 48" rebar
North 35.28' to set nail & tag in W. side 4" Birch
N69°E 30.88' to set nail & tag in SE. side 3" Red Maple
S60°E 5.76' to set nail & tag in S. side 2" Red Maple
N83°W 15.50' to set nail & tag in N. side 3" Red Maple
Set blue Carsonite post with location tag 1' North

Signed by: Joshua R. Davidson
Surveyor's Michigan License No.: 46659

Date: 11-29-2012