

SURVEY & REMONUMENTATION

SEP 07 1999

LAND CORNER RECORDATION CERTIFICATE
Filing Requirement of Act 74, Mich. P.A. 1970

KALKASKA COUNTY, MICHIGAN
RECEIVED

95 DEC 27 AM 9:54

Jane Hill

For corners in SECTION

KALKASKA (County)	Located In:	Corner Code #1
1995 REMONUMENTATION	26N 6W	A-1
1. Public Land Survey	T 27N R 7W	M-13
	T _____ R _____	_____
	T _____ R _____	_____
	T _____ R _____	_____
2. Property Controlling in Section	S _____ T _____ R _____	_____
3. Miscellaneous Property in Sec.	S _____ T _____ R _____	_____

Register of Deeds Stamp & File Number

4. Lot No. _____, Recorded Plat _____
5. Private Claims _____

	A	B	C	D	E	F	G	H	I	J	K	L	M
2	6		5		4		3		2				
3													
4	7		8		9		10		11		12		
5													
6	18		17		16		15		14		13		
7													
8	19		20		21		22		23		24		
9													
10	30		29		28		27		26		25		
11													
12	31		32		33		34		35		36		
13													

I, EUGENE FARRIER, in a field survey on Dec. 5, 19 95, do hereby certify that under requirements of P.A. 74, Michigan P.A. of 1970, the corner points mentioned in lines 1 and 2 above were in conformance with regulations and rules therefore as required in the current manual of survey instructions of the United States Department of the Interior, Bureau of Land Management or by a decree of a Court of Law and/or that the corner points mentioned in lines 3, 4 and 5 above were in conformance with the rules of the Michigan Board of Land Surveyors or by a Decree of a Court of Law; established, re-established, monumented, re-monumented, recovered, found as expressed below:

NOTE: Not more than 4 corners, all in the same town and range, may be recorded on this certificate.

A. Description of original monument and accessories and/or subsequent restoration:

M-13: Cor. common to Sec. 36, T27N-R7W, Kalkaska; Sec. 31, T27N-R6W, Excelsior; Sec. 1, T26N-R7W, Orange; Sec. 6, T26N-R6W, Oliver 1850, GLO resurvey, fd cor. post, Bch 15", N01E, 36; Sgr 10", N52.5W, 17. Oct-Nov-1972, C.F. Roser, DNR resurvey, Set DNR Mon, at Dbl. Dist & Extension of line through SW Cor & W 1/4 Cor of Sec 6. Fits Merrill Survey dated 1904 and old occupation. 6-18-1983, E.D. Farrier, Survey #17794, fd DNR Mon.

B. Description of corner evidence found and/or method applied in restoring or reestablishing corner:


M-13: Cor. common to Sec. 36, T27N-R7W, Kalkaska; Sec. 31, T27N-R6W, Excelsior; Sec. 1, T26N-R7W, Orange; Sec. 6, T26N-R6W, Oliver Left DNR Mon. in place, stamped "95 Remon" on cap. The Kalkaska Co. peer group approved the above monument as a careful and faithful reestablishment of the position of the original corner.

Ratified by Peer Group
P.A. 345 - 1990 Kalkaska County
Chairman Eugene Farrier
Date 12-19-95

C. Description of monument for corner and accessories established to perpetuate locating the position of the corner:

M-13: Cor. common to Sec. 36, T27N-R7W, Kalkaska; Sec. 31, T27N-R6W, Excelsior; Sec. 1, T26N-R7W, Orange; Sec. 6, T26N-R6W, Oliver Left DNR Mon. in place, stamped "95 Remon" on cap.
Set nail & tag S81W, 12" Maple, 7.12'
Set nail & tag N19E, 12" Maple, 9.27'
Set nail & tag East, 10" Maple, 11.66'
Set nail & tag S12E, 6" Balsam, 18.80'

Signed by Eugene Farrier Date 12-22-95
Surveyor's Michigan License No. 24594

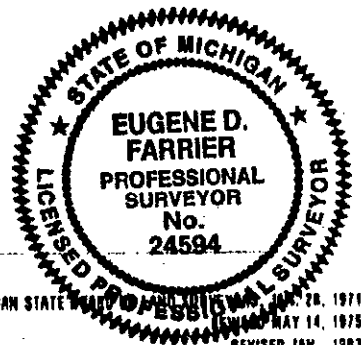

FORM APPROVED BY MICHIGAN STATE BOARD OF PROFESSIONAL SURVEYORS, REVISED JAN. 1993