

# SURVEY & REMONUMENTATION

MAR 21 1997

KALKASKA COUNTY, MICHIGAN  
RECEIVED

LAND CORNER RECORDATION CERTIFICATE 97 JAN 31 PM 2:42  
COMMISSION Filing Requirement of Act 74, Mich. P.A. 1970

For corners in

KALKASKA

(County)

Located In:

Corner Code 77

1996 REMONUMENTATION

1. Public Land Survey		T <u>26N</u> R <u>6W</u>			B-3
		T _____ R _____			_____
		T _____ R _____			_____
		T _____ R _____			_____
2. Property Controlling in Section	S _____	T _____ R _____			_____
	S _____	T _____ R _____			_____
3. Miscellaneous Property in Sec.	S _____	T _____ R _____			_____
	S _____	T _____ R _____			_____

*Joan Hall*  
REG. OF DEEDS

Register of Deeds Stamp & File Number

4. Lot No. \_\_\_\_\_, Recorded Plat \_\_\_\_\_  
5. Private Claims \_\_\_\_\_

	A	B	C	D	E	F	G	H	I	J	K	L	M
2	6	5	4	3	2	1							
3	7	8	9	10	11	12							
4													
5													
6	18	17	16	15	14	13							
7													
8	19	20	21	22	23	24							
9													
10	30	29	28	27	26	25							
11													
12	31	32	33	34	35	36							
13													

EUGENE FARRIER in a field survey on Nov. 13, 19 96,  
do hereby certify that under requirements of P.A. 74, Michigan P.A. of 1970, the corner points mentioned in lines 1 and 2 above were in conformance with regulations and rules therefore as required in the current manual of survey instructions of the United States Department of the Interior, Bureau of Land Management or by a decree of a Court of Law and/or that the corner points mentioned in lines 3, 4 and 5 above were in conformance with the rules of the Michigan Board of Land Surveyors or by a Decree of a Court of Law; established, re-established, monumented, re-monumented, recovered, found as expressed below:

**NOTE: Not more than 4 corners, all in the same town and range, may be recorded on this certificate.**

1. Description of original monument and accessories and/or subsequent restoration:

B-03 cor common to Sec. 6 & 7, T26N-R6W, Oliver Township  
1852, GLO resurvey, set post, 8"Beech 17W 21, 10"Sugar N23E 28.  
09-10-1880, G.A.Limpert, used corner, no accessories.  
04-17-1911, W.S.Merrill, Co. Surveyor, used corner, no accessories.  
11-09-1972, LCRC Liber 1 pg. 180.  
11-10-1972, C.L.Roser, fd 1 1/4" Pipe w/ nipple, no accessories.  
03-24-1973, N.F.Parker, fd 1 1/4" Pipe. Liber 1 pg. 280 in Survey.

2. Description of corner evidence found and/or method applied in restoring or reestablishing corner:


B-03 cor common to Sec. 6 & 7, T26N-R6W, Oliver Township  
Found 1 1/4" x 18" Iron Pipe w/ accessories. Pulled & Set 5/8" x 18" re-rod w/ Brass cap 2' North of centerline of Kniss Road. No G.L.O. witnesses found. The Kalkaska Co. peer group approved & accepted the above monument as a careful and faithful perpetuation of the position of the original corner.

**Ratified by Peer Group  
P.A. 345 - 1990 Kalkaska County**

Chairman Eugene Farrier  
Date 1-21-97

3. Description of monument for corner and accessories established to perpetuate locating the position of the corner:

B-03 cor common to Sec. 6 & 7, T26N-R6W, Oliver Township  
Found 1 1/4" x 18" Iron Pipe w/ accessories. Pulled & Set 5/8" x 18" re-rod w/ Brass cap 2' North of centerline of Kniss Road.  
Set nail & tag N25W 30" Tw. Maple, 41.50'  
North fd 1/2" re-rod, 33.13'  
Set nail & tag N55E 10" Tw. Beech, 49.68'  
Set nail & tag S05W 6" Scotch Pine, 75.22'

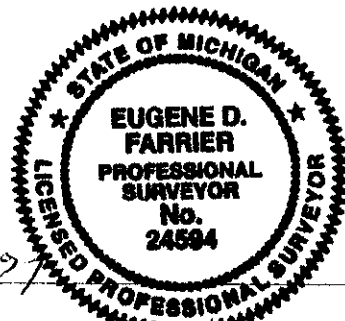

Signed by Eugene Farrier  
Surveyor's Michigan License No. 24594

Date 1-30-97