

SURVEY & REMONUMENTATION

MAR 21 1997

KALKASKA COUNTY, MICHIGAN
RECEIVED

COMMISSION

CORNER RECORDATION CERTIFICATE 97 JAN 31 PM 2:26
Requirement of Act 74, Mich. P.A. 1970

of corners in

KALKASKA
(County)

Located In:

Corner Code #:

Jean Hall
REC'D OFFICE

1996 REMONUMENTATION

1. Public Land Survey

T 27N	R 6W	C-13
T 26N	R 6W	
T	R	
T	R	

2. Property Controlling
in Section

S T R

3. Miscellaneous

S T R

Property in Sec.

S T R

Register of Deeds Stamp & File Number

1. Lot No. _____, Recorded Plat _____

2. Private Claims _____

	A	B	C	D	E	F	G	H	I	J	K	L	M
2	6	5	4	3	2	1							
3													
4	7	8	9	10	11	12							
5													
6	18	17	16	15	14	13							
7													
8	19	20	21	22	23	24							
9													
10	30	29	28	27	26	25							
11													
12	31	32	33	34	35	36							
13													

EUGENE FARRIER, in a field survey on Nov. 13, 1996

do hereby certify that under requirements of P.A. 74, Michigan P.A. of 1970, the corner points mentioned in lines 1 and 2 above were in conformance with regulations and rules therefore as required in the current manual of survey instructions of the United States Department of the Interior, Bureau of Land Management or by a decree of a Court of Law and/or that the corner points mentioned in lines 3, 4 and 5 above were in conformance with the rules of the Michigan Board of Land Surveyors or by a Decree of a Court of Law; established, re-established, monumented, re-monumented, recovered, found as expressed below:

NOTE: Not more than 4 corners, all in the same town and range, may be recorded on this certificate.

1. Description of original monument and accessories and/or subsequent restoration:

- C-13 cor common to Sec. 31 & 32, T27N-R6W Excelsior Township & Sec. 5 & 6, T26N-R6W, Oliver Township
- 1852, GLO resurvey, 10" Tamarack for corner, 6" Tamarack S60E 60, 6" Tamarack S62W 41.
- 08-06-1884, E. Mosher, Co. Surveyor, used corner, no accessories.
- 1888, E. Mosher, Co. Surveyor, used corner, no accessories.
- 11-09-1904, W.S. Merrill, Co. Surveyor, used corner, no accessories.
- 10-24-1972, C.L. Roser, recovered old IRS. per. added DNR mon., no accessories.
- 10-24-1972, LCRC Liber 1 pg. 179.
- 04-16-1973, N.F. Parker, fd DNR mon, Liber 1 pg. 305 in Survey.
- 09-24-1973, LCRC Liber 1 pg. 282.
- 09-24-1973, J.R. Radcliffe, fd DNR mon, Liber 1 pg. 443 in Survey.
- 01-30-1975, N.F. Parker, fd DNR mon, Liber 1 pg. 641 in Survey.
- 06-08-1990, E.D. Farrier, Survey #6490, fd DNR mon., w/ accessories.

2. Description of corner evidence found and/or method applied in restoring or reestablishing corner:


- C-13 cor common to Sec. 31 & 32, T27N-R6W Excelsior Township & Sec. 5 & 6, T26N-R6W, Oliver Township
- Found 1" DNR Pipe w/ no cap w/ accessories. Pulled & Set 5/8" x 18" re-rod w/ Brass cap in centerline of North Sharon Road and West of corner fence post. No G.L.O. witnesses found. The Kalkaska Co. peer group approved & accepted the above monument as a careful and faithful perpetuation of the position of the original corner.

3. Description of monument for corner and accessories established to perpetuate locating the position of the corner:

- C-13 cor common to Sec. 31 & 32, T27N-R6W Excelsior Township & Sec. 5 & 6, T26N-R6W, Oliver Township
- Found 1" DNR Pipe w/ no cap w/ accessories. Pulled & Set 5/8" x 18" re-rod w/ Brass cap in centerline of North Sharon Road and West of corner fence post.
- Set nail & tag N08W 8" W. Pine, 129.91'
- Set nail & tag N13E Power Pole, 147.01'
- Set nail & tag S05E Power Pole, 222.25'
- Set nail & tag S05W 12" Tamarack, 256.03'

Ratified by Peer Group
P.A. 345 - 1990 Kalkaska County

Chairman *Eugene Farrier*
Date 1-30-97

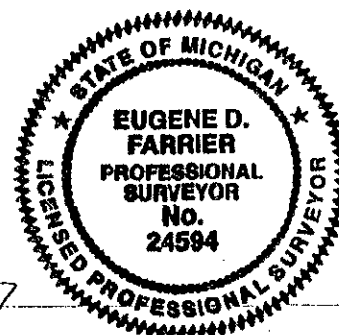

Signed by *Eugene Farrier*
Surveyor's Michigan License No. 24594

Date 1-30-97