

**SURVEY & REMONUMENTATION COMMISSION**

MAR 21 1997

KALKASKA COUNTY, MICHIGAN RECEIVED

**LAND CORNER RECORDATION CERTIFICATE**  
Filing Requirement of Act 74, Mich. P.A. 1970

97 JAN 31 PM 2:43

For corners in

KALKASKA  
(County)

Located In:

Corner Code #:

1996 REMONUMENTATION  
Public Land Survey

T 26N R 6W

C-3

T \_\_\_\_\_ R \_\_\_\_\_

T \_\_\_\_\_ R \_\_\_\_\_

T \_\_\_\_\_ R \_\_\_\_\_

T \_\_\_\_\_ R \_\_\_\_\_

2. Property Controlling  
in Section

S \_\_\_\_\_ T \_\_\_\_\_ R \_\_\_\_\_

S \_\_\_\_\_ T \_\_\_\_\_ R \_\_\_\_\_

3. Miscellaneous  
Property in Sec.

S \_\_\_\_\_ T \_\_\_\_\_ R \_\_\_\_\_

S \_\_\_\_\_ T \_\_\_\_\_ R \_\_\_\_\_

*Joan Hall*  
REG. DE. DEPT.

Register of Deeds Stamp & File Number

4. Lot No. \_\_\_\_\_, Recorded Plat \_\_\_\_\_

5. Private Claims \_\_\_\_\_

	A	B	C	D	E	F	G	H	I	J	K	L	M
2	6		5		4		3		2		1		
3			•										
4	7		8		9		10		11		12		
5													
6	18		17		16		15		14		13		
7													
8	19		20		21		22		23		24		
9													
10	30		29		28		27		26		25		
11													
12	31		32		33		34		35		36		
13													

EUGENE FARRIER in a field survey on Nov. 11, 1996

do hereby certify that under requirements of P.A. 74, Michigan P.A. of 1970, the corner points mentioned in lines 1 and 2 above were in conformance with regulations and rules therefore as required in the current manual of survey instructions of the United States Department of the Interior, Bureau of Land Management or by a decree of a Court of Law and/or that the corner points mentioned in lines 3, 4 and 5 above were in conformance with the rules of the Michigan Board of Land Surveyors or by a Decree of a Court of Law; established, re-established, monumented, re-monumented, recovered, found as expressed below:

**NOTE: Not more than 4 corners, all in the same town and range, may be recorded on this certificate.**

1. Description of original monument and accessories and/or subsequent restoration:

- C-03 cor common to Sec. 5, 6, 7 & 8, T26N-R6W, Oliver Township May 15, 1852, GLO resurvey, Set post. 11" Lynn N45W 25, 16" Lynn S25E 34.
- 09-10-1880, G.A. Limpert, Co. Surveyor, used corner, no accessories.
- 09-29-1903, W.S. Merrill, Co. Surveyor, fd stake, set iron pipe. No accessories.
- 05-15-1972, LCRC Liber 1 pg. 17.
- 11-09-1972, C.L. Roser, fd iron by R.L.S. Wilcox, no accessories.
- 11-09-1972, LCRC Liber 1 pg. 180.
- 03-24-1973, N.F. Parker, used corner, no accessories.
- 07-02-1973, N.F. Parker, used corner, no accessories.
- 08-03-1987, Farrier Surveying, Survey #12687, fd iron & cap, Liber 3 pg 156 of Survey.
- 09-03-1993, R.E. Pope, fd 1/2" iron, Liber 4 pg. 199 of Survey.

2. Description of corner evidence found and/or method applied in restoring or reestablishing corner:


C-03 cor common to Sec. 5, 6, 7 & 8, T26N-R6W, Oliver Township Found 1/2" iron & cap #14102 and 1 1/2" x 24" iron pipe. Pulled & Set 5/8" x 18" re-rod w/ Brass cap in c/l of intersection of Kniss Road & North Sharon road. No G.L.O. witnesses found. The Kalkaska Co. peer group approved & accepted the above monument as a careful and faithful reestablishment of the position of the original corner.

3. Description of monument for corner and accessories established to perpetuate locating the position of the corner:

C-03 cor common to Sec. 5, 6, 7 & 8, T26N-R6W, Oliver Township Found 1/2" iron & cap #14102 and 1 1/2" x 24" iron pipe. Pulled & Set 5/8" x 18" re-rod w/ Brass cap in c/l of intersection of Kniss Road & North Sharon road.  
Set nail & tag N45W Power Pole, 51.02'  
Set nail & tag S33E 8" Wood Guard Post (Telephone box), 48.49'  
Set nail & tag S50W Easterly 3"x3" Wood Sign Post (W.C.A.), 60.65'  
N61E Face of Stop Sign Post, 48.82'

Ratified by Peer Group  
 P.A. 345 - 1990 Kalkaska County  
 Chairman *[Signature]*  
 Date 1-21-97

Signed by *Eugene Farrier* Date \_\_\_\_\_  
 Surveyor's Michigan License No. 24594

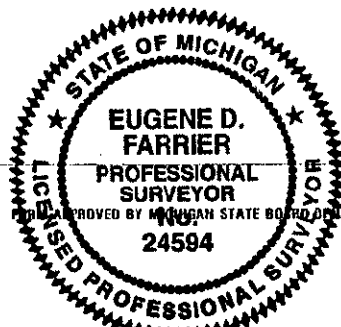

1-30-97  
 APPROVED BY MICHIGAN STATE BOARD OF LAND SURVEYORS, JAN. 28, 1971  
 REVISED MAY 14, 1975  
 REVISED JAN., 1993