

SURVEY & REMONUMENTATION

MAR 21 1997

LAND CORNER RECORDATION CERTIFICATE COMMISSION Filing Requirement of Act 74, Mich. P.A. 1970

KALKASKA COUNTY, MICHIGAN
RECEIVED

97 JAN 31 PM 2:43

Joan Hall
REG. OF DEEDS

or corners in			
<u>KALKASKA</u>	Located In:	Corner Code #/	
(County)			
1996 REMONUMENTATION			
1. Public Land Survey	T <u>26N</u> R <u>6W</u>	<u>C-4</u>	
	T _____ R _____	_____	
	T _____ R _____	_____	
	T _____ R _____	_____	
2. Property Controlling	S _____ T _____ R _____	_____	
In Section	S _____ T _____ R _____	_____	
3. Miscellaneous	S _____ T _____ R _____	_____	
Property in Sec.	S _____ T _____ R _____	_____	

Register of Deeds Stamp & File Number

4. Lot No. _____, Recorded Plat _____
 5. Private Claims _____

	A	B	C	D	E	F	G	H	I	J	K	L	M
2	6		5		4		3		2		1		
3													
4	7	●	8		9		10		11		12		
5													
6	18		17		16		15		14		13		
7													
8	19		20		21		22		23		24		
9													
10	30		29		28		27		26		25		
11													
12	31		32		33		34		35		36		
13													

EUGENE FARRIER, in a field survey on Nov. 21, 1996,
 do hereby certify that under requirements of P.A. 74, Michigan P.A. of 1970, the corner points mentioned
 in lines 1 and 2 above were in conformance with regulations and rules therefore as required in the
 current manual of survey instructions of the United States Department of the Interior, Bureau of Land
 Management or by a decree of a Court of Law and/or that the corner points mentioned in lines 3, 4 and 5
 above were in conformance with the rules of the Michigan Board of Land Surveyors or by a Decree of a
 Court of Law; established, re-established, monumented, re-monumented, recovered, found as
 expressed below:

**NOTE: Not more than 4 corners, all in the same town and range, may be recorded
 on this certificate.**

6. Description of original monument and accessories and/or subsequent restoration:

C-04 cor common to Sec. 7 & 8, T26N-R6W, Oliver Township
 1852, GLO resurvey, Set post. 22" Sugar S40W 31, 16" Sugar N20E 12.
 09-29-1903. W.S. Merrill, Co. Surveyor, fd & set iron stake, no
 accessories.
 05-15-1972, LCRC Liber 1 pg. 18.

7. Description of corner evidence found and/or method applied in restoring or reestablishing corner:


C-04 cor common to Sec. 7 & 8, T26N-R6W, Oliver Township
 Found 1 1/4" x 18" Iron Pipe w/ accessories. Pulled & Set 5/8" x 18"
 re-rod w/ Brass cap in Mon Box in center line of North Sharon Rd. No
 G.L.O. witnesses found. The Kalkaska Co. peer group approved & accepted
 the above monument as a careful and faithful perpetuation of the position
 of the original corner.

**Ratified by Peer Group
 P.A. 345 - 1990 Kalkaska County**

Chairman *Eugene Farrier*
 Date 1-21-97

8. Description of monument for corner and accessories established to perpetuate locating the position of the corner:

C-04 cor common to Sec. 7 & 8, T26N-R6W, Oliver Township
 Found 1 1/4" x 18" Iron Pipe w/ accessories. Pulled & Set 5/8" x 18"
 re-rod w/ Brass cap in Mon Box in center line of North Sharon Rd.
 Set nail & tag N10W Power Pole, 134.60'
 Set nail & tag S81E 30" Maple, 79.70'
 Set nail & tag S59E 10" R. Pine, 49.33'
 S35W 5/8" x 18" re-rod, 36.64'

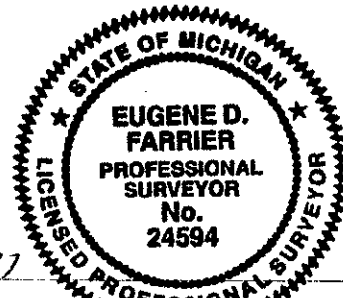

Signed by *Eugene Farrier*
 Surveyor's Michigan License No. 24594

Date 1-30-97