

SURVEY & REMONUMENTATION COMMISSION

MAR 21 1997

LAND CORNER RECORDATION CERTIFICATE
Filing Requirement of Act 74, Mich. P.A. 1970

KALKASKA COUNTY, MICHIGAN RECEIVED

97 JAN 31 PM 2:43

Joan Hall
REG. OF DEEDS

For corners in

KALKASKA
(County)

Located In:

Corner Code #

1996 REMONUMENTATION

1. Public Land Survey	T <u>26N</u> R <u>6W</u>	C-5
	T _____ R _____	_____
	T _____ R _____	_____
	T _____ R _____	_____
2. Property Controlling in Section	S _____ T _____ R _____	_____
	S _____ T _____ R _____	_____
3. Miscellaneous Property in Sec.	S _____ T _____ R _____	_____

Register of Deeds Stamp & File Number

1. Lot No. _____, Recorded Plat _____
2. Private Claims _____

	A	B	C	D	E	F	G	H	I	J	K	L	M
2	6	5	4	3	2	1							
3													
4	7	8	9	10	11	12							
5		•											
6	18	17	16	15	14	13							
7													
8	19	20	21	22	23	24							
9													
10	30	29	28	27	26	25							
11													
12	31	32	33	34	35	36							
13													

EUGENE FARRIER in a field survey on Nov. 21, 19 96
to hereby certify that under requirements of P.A. 74, Michigan P.A. of 1970, the corner points mentioned in lines 1 and 2 above were in conformance with regulations and rules therefore as required in the current manual of survey instructions of the United States Department of the Interior, Bureau of Land Management or by a decree of a Court of Law and/or that the corner points mentioned in lines 3, 4 and 5 above were in conformance with the rules of the Michigan Board of Land Surveyors or by a Decree of a Court of Law; established, re-established, monumented, re-monumented, recovered, found as expressed below:


NOTE: Not more than 4 corners, all in the same town and range, may be recorded on this certificate.

1. Description of original monument and accessories and/or subsequent restoration:
C-05 cor common to Sec. 7, 8, 17 & 18, T26N-R6W, Oliver Township 1852, GLO resurvey, Set post. 12" Sugar S80E 8, 10" Sugar N73W 35. July 1894, W.S. Merrill, Co. Surveyor, used corner, no accessories. 09-29-1903, W.S. Merrill, Co. Surveyor, used corner, no accessories. 08-29-1904, W.S. Merrill, Co. Surveyor, used corner, no accessories. Nov. 1975, H.L. Fluharty, fd spike. Liber 1 pg. 766 of Survey. 09-18-1975, LCRC Liber 1 pg. 364-A. July 1979, LCRC Liber 2 pg. 185. 08-14-1979, J.L. Fletcher, fd cement nail replaced w/ 1/2" iron & cap. Liber 2 pg. 377 of Survey.

2. Description of corner evidence found and/or method applied in restoring or reestablishing corner:
C-05 cor common to Sec. 7, 8, 17 & 18, T26N-R6W, Oliver Township Found 1/2" x 24" re-rod w/ cap #19830 w/ accessories. Pulled & Set 5/8" x 18" re-rod w/ Brass cap in Mon Box in centerline of intersection of North Sharon Rd. & Cool Rd. No G.L.O. witnesses found. The Kalkaska Co. peer group approved & accepted the above monument as the best available evidence of the position of the original corner.

Ratified by Peer Group
P.A. 345 - 1990 Kalkaska County
Chairman *Eugene Farrier*
Date 1-27-97

3. Description of monument for corner and accessories established to perpetuate locating the position of the corner:
C-05 cor common to Sec. 7, 8, 17 & 18, T26N-R6W, Oliver Township Found 1/2" x 24" re-rod w/ cap #19830 w/ accessories. Pulled & Set 5/8" x 18" re-rod w/ Brass cap in Mon Box in centerline of intersection of North Sharon & Cool Rd.
Set nail & tag N36W Power Pole, 46.35'
Set nail & tag N49E Support Pole, 51.85'
Set nail & tag S51E 12" R. Pine, 68.13'
Set nail & tag S70W Service Pole, 58.14'

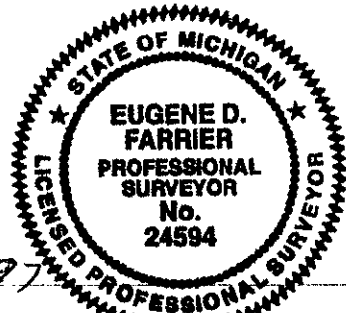

Signed by *Eugene Farrier* Date 1-30-97
Surveyor's Michigan License No. 24594