

SURVEY & REMONUMENTATION

MAR 21 1997

KALKASKA COUNTY, MICHIGAN RECEIVED

LAND CORNER RECORDATION CERTIFICATE
COMMISSION Filing Requirement of Act 74, Mich. P.A. 1970

97 JAN 31 PM 2:44

For corners in

KALKASKA
 (County)

Located In:

Corner Code #

1996 REMONUMENTATION

1. Public Land Survey	T <u>26N</u> R <u>6W</u>	D-5
	T _____ R _____	_____
	T _____ R _____	_____
	T _____ R _____	_____
2. Property Controlling in Section	S _____ T _____ R _____	_____
	S _____ T _____ R _____	_____
3. Miscellaneous Property in Sec.	S _____ T _____ R _____	_____
	S _____ T _____ R _____	_____

Joan Hall
 REG. OF DEEDS

Register of Deeds Stamp & File Number

4. Lot No. _____, Recorded Plat _____
 5. Private Claims _____

	A	B	C	D	E	F	G	H	I	J	K	L	M
2	6	5	4	3	2	1							
3													
4	7	8	9	10	11	12							
5		•											
6	18	17	16	15	14	13							
7													
8	19	20	21	22	23	24							
9													
10	30	29	28	27	26	25							
11													
12	31	32	33	34	35	36							
13													

EUGENE FARRIER in a field survey on Sept. 27, 19 96

do hereby certify that under requirements of P.A. 74, Michigan P.A. of 1970, the corner points mentioned in lines 1 and 2 above were in conformance with regulations and rules therefore as required in the current manual of survey instructions of the United States Department of the Interior, Bureau of Land Management or by a decree of a Court of Law and/or that the corner points mentioned in lines 3, 4 and 5 above were in conformance with the rules of the Michigan Board of Land Surveyors or by a Decree of a Court of Law; established, re-established, monumented, re-monumented, recovered, found as expressed below:

NOTE: Not more than 4 corners, all in the same town and range, may be recorded on this certificate.

A. Description of original monument and accessories and/or subsequent restoration:

- D-05 cor common to Sec. 8 & 17, T26N-R6W, Oliver Township 1852, GLO resurvey, Set Post. 12"Beech N40E 19, 12"Beech S04W 15.
- 09-10-1880, G.A.Limpert, used corner, no accessories.
- 09-29-1903, W.S.Merrill, Co. Surveyor, iron stake, no accessories.
- 09-21-1972, LCRC Liber 1 pg. 89.
- 09-25-1972, J.H.Granger, used corner, Liber 1 pgs. 199,200,201&202 of Surveys.
- 09-18-1975, LCRC Liber 1 pg. 364-A.
- 11-06-1975, H.L.Fluharty, fd 2 1/2" Hex Bolt. Liber 1 pg.766.
- July 1979, LCRC Liber 2 pg.185.
- 08-14-1979, J.L.Fletcher, fd 2 1/2" Hex Bolt. Liber 2 pg. 377.
- 05-15-1987, E.D.Farrier, Survey #6587, fd 1 1/2" iron pipe, no accessories. Liber 3 pg. 127.
- 07-07-1995, R.J.Kral, Survey #10795, fd 2 1/2" Bolt, w/ accessories.


B. Description of corner evidence found and/or method applied in restoring or reestablishing corner:

D-05 cor common to Sec. 8 & 17, T26N-R6W, Oliver Township Found 2 1/2"x1"x16" Hex bolt w/ accessories. Pulled & Set 5/8" x 18" re-rod w/ Brass cap 2' South of centerline of Cool Road & on Maple tree R.O.W. to North. No G.L.O. witnesses were found. The Kalkaska Co. peer group approved & accepted the above monument as a careful and faithful perpetuation of the position of the original corner.

C. Description of monument for corner and accessories established to perpetuate locating the position of the corner:

D-05 cor common to Sec. 8 & 17, T26N-R6W, Oliver Township Found 2 1/2"x1"x16" Hex bolt w/ accessories. Pulled & Set 5/8" x 18" re-rod w/ Brass cap 2' South of centerline of Cool Road & on Maple tree R.O.W. to North.
 Set nail & tag N35W 17" Maple, 32.88' (old wit).
 Set nail & tag North 13" Maple, 29.32' (old wit).
 Set nail & tag N53E 17" Maple, 41.24' (old wit).
 Set nail & tag S05W Power Pole 35.13' (old wit).

Ratified by Peer Group
 P.A. 345 - 1990 Kalkaska County
 Chairman *[Signature]*
 Date 1-30-97

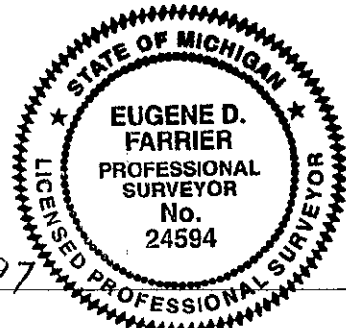

Signed by *Eugene Farrier*
 Surveyor's Michigan License No. 24594

Date 1-30-97