

# SURVEY & REMONUMENTATION

MAR 21 1997

COMMISSION

KALKASKA COUNTY, MICHIGAN RECEIVED

## LAND CORNER RECORDATION CERTIFICATE Filing Requirement of Act 74, Mich. P.A. 1970

97 JAN 31 PM 2:44

For corners in

KALKASKA

(County)

Located In:

Corner Code #/

1996 REMONUMENTATION

- |                                    |                          |            |
|------------------------------------|--------------------------|------------|
| 1. Public Land Survey              | T <u>26N</u> R <u>6W</u> | <u>E-3</u> |
|                                    | T _____ R _____          | _____      |
|                                    | T _____ R _____          | _____      |
|                                    | T _____ R _____          | _____      |
| 2. Property Controlling in Section | S _____ T _____ R _____  | _____      |
|                                    | S _____ T _____ R _____  | _____      |
| 3. Miscellaneous Property in Sec.  | S _____ T _____ R _____  | _____      |
|                                    | S _____ T _____ R _____  | _____      |

*Jean Hall*  
REG. OF DEEDS

Register of Deeds Stamp & File Number

4. Lot No. \_\_\_\_\_, Recorded Plat \_\_\_\_\_  
5. Private Claims \_\_\_\_\_

	A	B	C	D	E	F	G	H	I	J	K	L	M
2	6	5	4	3	2	1							
3													
4	7	8	9	10	11	12							
5													
6	18	17	16	15	14	13							
7													
8	19	20	21	22	23	24							
9													
10	30	29	28	27	26	25							
11													
12	31	32	33	34	35	36							
13													

EUGENE FARRIER, in a field survey on Nov. 21, 19 96, to hereby certify that under requirements of P.A. 74, Michigan P.A. of 1970, the corner points mentioned in lines 1 and 2 above were in conformance with regulations and rules therofore as required in the current manual of survey instructions of the United States Department of the Interior, Bureau of Land Management or by a decree of a Court of Law and/or that the corner points mentioned in lines 3, 4 and 5 above were in conformance with the rules of the Michigan Board of Land Surveyors or by a Decree of a Court of Law; established, re-established, monumented, re-monumented, recovered, found as expressed below:

**NOTE: Not more than 4 corners, all in the same town and range, may be recorded on this certificate.**

1. Description of original monument and accessories and/or subsequent restoration:

- E-03 cor common to Sec. 4, 5, 8 & 9, T26N-R6W, Oliver Township 1852, GLO resurvey, Set Post. 8" Beech N68E, 6" Beech S67W, no distances. 09-10-1880, G.A. Limpert, used corner, no accessories.
- 09-29-1903, W.S. Merrill, Co. Surveyor, iron stake wagon skein, no accessories.
- 1959, K.J. Ostling, from corner approx. rd int. chain E. btw. 4 & 9.
- 05-15-1972, LCRC Liber 1 pg. 14.
- 05-18-1972, J.L. Wilcox, fd 1" axle. Liber 1 pg. 2, 3, 4, 5 & 6 of Surveys.
- 05-03-1976, J.L. Fletcher, fd Boat spike. Liber 1 pg. 872 of Survey.
- 10-06-1976, J.L. Fletcher, fd Boat spike. Liber 1 pg. 934 of Survey.
- 06-15-1988, B.M. Jones, fd Boat spike. Liber 3 pg 228 of Survey.
- 06-15-1988, LCRC Liber 2 pg. 343.
- 10-28-1988, G.F. DeLaMater, used corner. Liber 3 pg. 272 of Survey.
- 10-31-1988, LCRC Liber 2 pg. 371.
- 08-13-1990, E.D. Farrier, Survey #9290, fd sm Boat spike, w/ accessories.
- 05-11-1992, E.D. Farrier, Survey #8092, used corner, w/ accessories.

Ratified by Peer Group  
P.A. 345 - 1990 Kalkaska County

Chairman


Date

2. Description of corner evidence found and/or method applied in restoring or reestablishing corner:

E-03 cor common to Sec. 4, 5, 8 & 9, T26N-R6W, Oliver Township Found Buggy Axle & Boat spike w/ accessories. Pulled & Set 5/8" x 18" re-rod w/ Brass cap in centerline of intersection of Sigma Road & Kniss Road. No G.L.O. witnesses found. The Kalkaska Co. peer group approved & accepted the above monument as a careful and faithful perpetuation of the position of the original corner.

3. Description of monument for corner and accessories established to perpetuate locating the position of the corner:

- E-03 cor common to Sec. 4, 5, 8 & 9, T26N-R6W, Oliver Township Found Buggy Axle & Boat spike w/ accessories. Pulled & Set 5/8" x 18" re-rod w/ Brass cap in centerline of intersection of Sigma Road & Kniss Road.
- Set nail & tag N47W Power Pole, 73.67'
- Set nail & tag N19E Cor. Fence Post, 107.41'
- Set nail & tag S36E Power Pole, 46.89'
- Set nail & tag N45E 12" Juniper, 66.57'

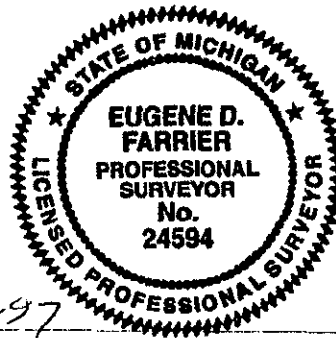

Signed by Eugene Farrier  
Surveyor's Michigan License No. 24594

Date 1-30-97