

SURVEY & REMONUMENTATION

KALKASKA COUNTY, MICHIGAN RECEIVED

MAR 21 1997 LAND CORNER RECORDATION CERTIFICATE

97 JAN 31 PM 2:44

COMMISSION

Filing Requirement of Act 74, Mich. P.A. 1970

Joan Hall
REG. OF DEEDS

or corners in

KALKASKA

(County)

Located In:

Corner Code #

1996 REMONUMENTATION
Public Land Survey

T 26N R 6W E-5

T R

T R

T R

T R

Property Controlling

S T R

in Section

S T R

Miscellaneous

S T R

Property in Sec.

S T R

Register of Deeds Stamp & File Number

Lot No. , Recorded Plat

Private Claims

	A	B	C	D	E	F	G	H	I	J	K	L	M
2	6		5		4		3		2		1		
3													
4	7		8		9		10		11		12		
5													
6	18		17		16		15		14		13		
7													
8	19		20		21		22		23		24		
9													
10	30		29		28		27		26		25		
11													
12	31		32		33		34		35		36		
13													

EUGENE FARRIER in a field survey on Oct. 2, 1996

hereby certify that under requirements of P.A. 74, Michigan P.A. of 1970, the corner points mentioned in lines 1 and 2 above were in conformance with regulations and rules therefore as required in the current manual of survey instructions of the United States Department of the Interior, Bureau of Land Management or by a decree of a Court of Law and/or that the corner points mentioned in lines 3, 4 and 5 above were in conformance with the rules of the Michigan Board of Land Surveyors or by a Decree of a Court of Law; established, re-established, monumented, re-monumented, recovered, found as expressed below:

NOTE: Not more than 4 corners, all in the same town and range, may be recorded on this certificate.

Description of original monument and accessories and/or subsequent restoration:

- E-05 cor common to Sec. 8, 9, 16 & 17, T26N-R6W, Oliver Township 1852, GLO resurvey, Set Post. 18" Beech S24W 32, 14" Sugar N45E 45.
- 09-29-1903, W.S. Merrill, Co. Surveyor, fd stake set iron, no accessories
- 09-21-1972, LCRC Liber 1 pg. 89.
- 09-25-1972, J.H. Granger, used corner, Liber 1 pgs. 199-202 of Surveys.
- 09-18-1975, LCRC Liber 1 pg. 364A.
- 06-06-1988, E.D. Farrier, Survey #8188, used corner, no accessories.
- Oct. 1989, LCRC Liber 2 pg. 386.
- 11-02-1989, E.D. Farrier, Survey #19989, fd R.R. iron by doubling over fd well pt.. Liber 3 pg. 317.
- 05-28-1992, E.D. Farrier, Survey #8188A, fd cabin spike, w/ accessories.
- 07-07-1995, E.D. Farrier, Survey #10795, fd 3/4" iron bar, w/ accessories.

Description of corner evidence found and/or method applied in restoring or reestablishing corner:

- E-05 cor common to Sec. 8, 9, 16 & 17, T26N-R6W, Oliver Township Found R.R. iron & 1/2" iron pipe & cabin spike w/ accessories. Pulled & Set 5/8" x 18" re-rod w/ Brass cap, cor falls 5' South & 3' West of c/l of intersection of Sigma Rd & Cool Rd. No G.L.O. witnesses were found. The Kalkaska Co. peer group approved & accepted the above monument as a careful and faithful perpetuation of the position of the original corner.


Description of monument for corner and accessories established to perpetuate locating the position of the corner:

- E-05 cor common to Sec. 8, 9, 16 & 17, T26N-R6W, Oliver Township Found R.R. iron & 1/2" iron pipe & cabin spike w/ accessories. Pulled & Set 5/8" x 18" re-rod w/ Brass cap, cor falls 5' South & 3' West of c/l of intersection of Sigma Rd & Cool Rd.
- Set nail & tag N47E 8" R. Pine, 79.54'.
- Set nail & tag S48E 7" Cherry, 63.03'.
- Set nail & tag S38W 8" Maple, 66.08'.
- Set nail & tag N32W Power Pole, 68.73'.

Ratified by Peer Group
P.A. 345 - 1990 Kalkaska County

Chairman *Eugene Farrier*

Date 1-21-97

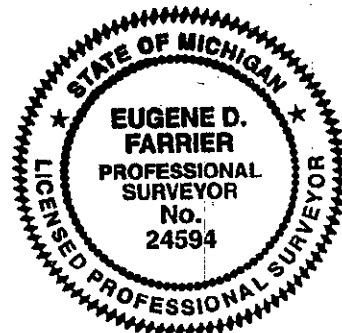

igned by *Eugene Farrier*

Date 1-30-97

urveyor's Michigan License No. 24594