

SURVEY & REMONUMENTATION

MAR 21 1997

COMMISSION

KALKASKA COUNTY, MICHIGAN RECEIVED

LAND CORNER RECORDATION CERTIFICATE JAN 31 PH 2:44
Filing Requirement of Act 74, Mich. P.A. 1970

Jan Hall
REG. DEEDS

For corners in

KALKASKA

(County)

Located In:

Corner Code #:

1996 REMONUMENTATION

- | | | |
|------------------------------------|--------------------------|------------|
| 1. Public Land Survey | T <u>26N</u> R <u>6W</u> | <u>E-7</u> |
| | T _____ R _____ | _____ |
| | T _____ R _____ | _____ |
| | T _____ R _____ | _____ |
| 2. Property Controlling in Section | S _____ T _____ R _____ | _____ |
| | S _____ T _____ R _____ | _____ |
| 3. Miscellaneous | S _____ T _____ R _____ | _____ |
| Property in Sec. | S _____ T _____ R _____ | _____ |

Register of Deeds Stamp & File Number

4. Lot No. _____, Recorded Plat _____
5. Private Claims _____

	A	B	C	D	E	F	G	H	I	J	K	L	M
2	6	5	4	3	2	1							
3													
4	7	8	9	10	11	12							
5													
6	18	17	16	15	14	13							
7													
8	19	20	21	22	23	24							
9													
10	30	29	28	27	26	25							
11													
12	31	32	33	34	35	36							
13													

I, EUGENE FARRIER, in a field survey on Oct. 1, 1996, do hereby certify that under requirements of P.A. 74, Michigan P.A. of 1970, the corner points mentioned in lines 1 and 2 above were in conformance with regulations and rules therefore as required in the current manual of survey instructions of the United States Department of the Interior, Bureau of Land Management or by a decree of a Court of Law and/or that the corner points mentioned in lines 3, 4 and 5 above were in conformance with the rules of the Michigan Board of Land Surveyors or by a Decree of a Court of Law; established, re-established, monumented, re-monumented, recovered, found as expressed below:

NOTE: Not more than 4 corners, all in the same town and range, may be recorded on this certificate.

A. Description of original monument and accessories and/or subsequent restoration:

- E-07 cor common to Sec. 16, 17, 20 & 21 T26N-R6W, Oliver Township May 17, 1852, GLO resurvey, Set Post. 10" Cedar S50W 25, 12" Cedar N73E 21.
- 08-12-1879, E. Mosher, Co. Surveyor, used corner, no accessories.
- 07-19-1901, W.S. Merrill, Co. Surveyor, used corner, no accessories.
- 09-21-1972, LCRC Liber 1 pg. 89.
- 09-18-1975, LCRC Liber 1 pg. 364A.
- 05-15-1987, E.D. Farrier, Survey #6587, fd 1/2" pipe. Liber 3 pg. 127.

3. Description of corner evidence found and/or method applied in restoring or reestablishing corner:

E-07 cor common to Sec. 16, 17, 20 & 21 T26N-R6W, Oliver Township Found 1/2" i.d. x 3/4" o.d. x 36" iron pipe w/ accessories. Pulled & Set 5/8" x 18" re-rod w/ Brass cap in centerline of 3-way intersection. No G.L.O. witnesses were found. The Kalkaska Co. peer group approved & accepted the above monument as a careful and faithful reestablishment of the position of the original corner.

Ratified by Peer Group


P.A. 345 - 1990 Kalkaska County

Chairman *Eugene Farrier*

Date 1-21-97

Description of monument for corner and accessories established to perpetuate locating the position of the corner:

- E-07 cor common to Sec. 16, 17, 20 & 21 T26N-R6W, Oliver Township Found 1/2" i.d. x 3/4" o.d. x 36" iron pipe w/ accessories. Pulled & Set 5/8" x 18" re-rod w/ Brass cap in centerline of 3-way intersection.
- Set nail & tag N55E 6" Elm, 49.97'.
- Set nail & tag S12W 9" Cedar, 36.36' (old wit).
- Set nail & tag S40W 8" Cedar, 38.60'
- Set nail & tag N40W Power Pole, 49.83' (old wit).

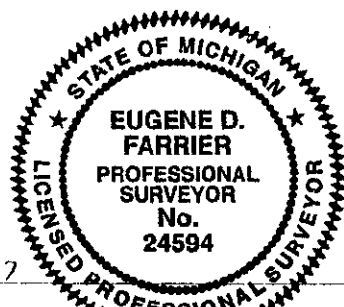

Signed by *Eugene Farrier*
Surveyor's Michigan License No. 24594

Date 1-30-97