

SURVEY & REMONUMENTATION

MAR 21 1997

COMMISSION

KALKASKA COUNTY, MICHIGAN RECEIVED

CORNER RECORDATION CERTIFICATE
Requirement of Act 74, Mich. P.A. 1970

97 JAN 31 PM 2:26

Joan Hall
REG. CLERK

or corners in

KALKASKA

(County)

Located in:

Corner Code #1

1996 REMONUMENTATION
Public Land Survey

T 27N R 6W

T 26N R 6W

T R

T R

F-13

(Handwritten circle around F-13)

Property Controlling

S T R

in Section

S T R

Miscellaneous

S T R

Property in Sec.

S T R

Register of Deeds Stamp & File Number

Lot No. _____, Recorded Plat _____

Private Claims _____

	A	B	C	D	E	F	G	H	I	J	K	L	M
2	6	5	4	3	2								
3													
4	7	8	9	10	11	12							
5													
6	10	17	16	15	14	13							
7													
8	19	20	21	22	23	24							
9													
10	30	29	28	27	26	25							
11													
12	31	32	33	34	35	36							
13													

EUGENE FARRIER in a field survey on July 8, 1996, hereby certify that under requirements of P.A. 74, Michigan P.A. of 1970, the corner points mentioned in lines 1 and 2 above were in conformance with regulations and rules therefore as required in the current manual of survey instructions of the United States Department of the Interior, Bureau of Land Management or by a decree of a Court of Law and/or that the corner points mentioned in lines 3, 4 and 5 above were in conformance with the rules of the Michigan Board of Land Surveyors or by a Decree of a Court of Law; established, re-established, monumented, re-monumented, recovered, found as expressed below:

(NOTE: Not more than 4 corners, all in the same town and range, may be recorded on this certificate.)

1. Description of original monument and accessories and/or subsequent restoration:

F-13 cor common to Sec. 33, T27N-R6W, Excelsior Township & Sec. 4, T26N-R6W, Oliver Township
1852, GLO resurvey, Set Post. 10" Sugar N57.5W 18, 10" Sugar N71E 27.
09-02-1903, W.S. Merrill, Co. Surveyor, used corner, w/ accessories.
1959, K.J. Ostling, used corner, w/ accessories.
08-02-1990, LCRC Liber 2 pg. 423.

2. Description of corner evidence found and/or method applied in restoring or reestablishing corner:

F-13 cor common to Sec. 33, T27N-R6W, Excelsior Township & Sec. 4, T26N-R6W, Oliver Township
Found 1/2" iron & cap #24594 w/ accessories, Pulled & Set 5/8" x 36" re-rod w/ Alum. cap, cor falls in N. edge of E-W trail & 24' N. of r/w fence to W., 8' N. & 8' W. of E-S fence cor, also 136' W. of fence to North. No G.L.O. witnesses were found. The Kalkaska Co. peer group approved & accepted the above monument as a careful and faithful reestablishment of the position of the original corner.

Ratified by Peer Group
P.A. 345 - 1990 Kalkaska County

Chairman *Eugene FARRIER*

Date 1-21-97


3. Description of monument for corner and accessories established to perpetuate locating the position of the corner:

F-13 cor common to Sec. 33, T27N-R6W, Excelsior Township & Sec. 4, T26N-R6W, Oliver Township
Found 1/2" iron & cap #24594 w/ accessories. Pulled & Set 5/8" x 36" re-rod w/ Alum. cap, cor falls in N. edge of E-W trail & 24' N. of r/w fence to W., 8' N. & 8' W. of E-S fence cor, also 136' W. of fence to North.
Set nail & tag S11E 28" Maple, 41.45'
Set nail & tag S12W 28" Maple, 54.73'
Set nail & tag N38W 6" R. Pine, 37.64'
Set nail & tag N85E 28" Maple, 87.08'

Signed by *Eugene FARRIER*

Date 1-30-97

Surveyor's Michigan License No. 24594

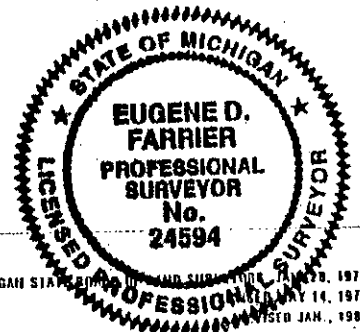

FORM APPROVED BY MICHIGAN STATE BOARD OF LAND SURVEYORS, JAN. 14, 1975
REVISED JAN., 1983