

**SURVEY & REMONUMENTATION**

MAR 21 1997

KALKASKA COUNTY, MICHIGAN  
RECEIVED

COMMISSION

LAND CORNER RECORDATION CERTIFICATE  
Filing Requirement of Act 74, Mich. P.A. 1970

*Joan Hall*  
REG. DEEDS

For corners in

KALKASKA (County)	Located In:	Corner Code #/
1996 REMONUMENTATION		
1. Public Land Survey	T <u>26N</u> R <u>6W</u>	<u>F-3</u>
	T _____ R _____	_____
	T _____ R _____	_____
	T _____ R _____	_____
2. Property Controlling in Section	S _____ T _____ R _____	_____
	S _____ T _____ R _____	_____
3. Miscellaneous Property in Sec.	S _____ T _____ R _____	_____
	S _____ T _____ R _____	_____
4. Lot No. _____, Recorded Plat _____		
5. Private Claims _____		

Register of Deeds Stamp & File Number

	A	B	C	D	E	F	G	H	I	J	K	L	M
2	6	5	4	3	2	1							
3													
4	7	8	9	10	11	12							
5													
6	18	17	16	15	14	13							
7													
8	19	20	21	22	23	24							
9													
10	30	29	28	27	26	25							
11													
12	31	32	33	34	35	36							
13													

I, EUGENE FARRIER, in a field survey on July 8, 19 96, do hereby certify that under requirements of P.A. 74, Michigan P.A. of 1970, the corner points mentioned in lines 1 and 2 above were in conformance with regulations and rules therefore as required in the current manual of survey instructions of the United States Department of the Interior, Bureau of Land Management or by a decree of a Court of Law and/or that the corner points mentioned in lines 3, 4 and 5 above were in conformance with the rules of the Michigan Board of Land Surveyors or by a Decree of a Court of Law; established, re-established, monumented, re-monumented, recovered, found as expressed below:

**NOTE: Not more than 4 corners, all in the same town and range, may be recorded on this certificate.**

**A. Description of original monument and accessories and/or subsequent restoration:**

F-03 cor common to Sec. 4 & 9, T26N-R6W, Oliver Township  
1852, GLO resurvey, Set Post. 12"Y. Birch S81W 29, 8"B. Ash N74E 10.  
09-10-1880, G.A.Limpert, used corner, no accessories.  
Aug. 1957, K.J.Ostling, from corner approx. cen rd chain E. btw. 4 & 9.  
05-03-1976, J.L.Fletcher, fd 1/2" re-rod. Liber 1 pg. 872 of Survey.  
10-31-1988, LCRC Liber 2 pg. 371.  
08-13-1990, E.D.Farrier, Survey #9290, fd 1/2" re-rod, w/ accessories.  
05-11-1992, E.D.Farrier, Survey #7392, fd 1/2" re-rod, w/ accessories.


**B. Description of corner evidence found and/or method applied in restoring or reestablishing corner:**

F-03 cor common to Sec. 4 & 9, T26N-R6W, Oliver Township  
Found 1/2" iron set by Fletcher w/ accessories. Pulled & Set 5/8" x 18" re-rod w/ Brass cap 5' North of centerline of Kniss Road. No G.L.O. witnesses were found. The Kalkaska Co. peer group approved & accepted the above monument as the best available evidence of the position of the original corner.

**Ratified by Peer Group**  
**P.A. 345 - 1990 Kalkaska County**  
**Chairman** *Eugene Farrier*  
**Date** 1-21-97

**C. Description of monument for corner and accessories established to perpetuate locating the position of the corner:**

F-03 cor common to Sec. 4 & 9, T26N-R6W, Oliver Township  
Found 1/2" iron set by Fletcher w/ accessories. Pulled & Set 5/8" x 18" re-rod w/ Brass cap 5' North of centerline of Kniss Road.  
Set nail & tag S48E 8" Maple, 31.85'.  
Set nail & tag S20E 10" Cedar, 50.18'.  
Set nail & tag South 6" Balsam, 18.54'.  
North iron & cap #24594, 33.00'.

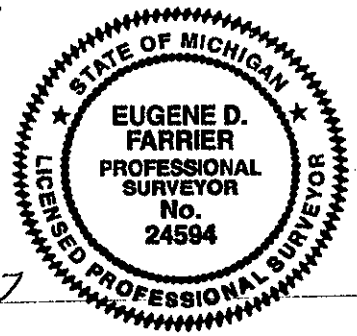

Signed by *Eugene Farrier* Date 1-30-97  
Surveyor's Michigan License No. 24594