

SURVEY & REMONUMENTATION

MAR 21 1997

COMMISSION

KALKASKA COUNTY, MICHIGAN RECEIVED

97 JAN 31 PM 2:45

LAND CORNER RECORDATION CERTIFICATE
Filing Requirement of Act 74, Mich. P.A. 1970

For corners in

KALKASKA

(County)

Located In:

Corner Code #1

1996 REMONUMENTATION

- 1. Public Land Survey T 26N R 6W G-2
- T _____ R _____
- T _____ R _____
- T _____ R _____
- 2. Property Controlling S _____ T _____ R _____
- in Section S _____ T _____ R _____
- 3. Miscellaneous S _____ T _____ R _____
- Property in Sec. S _____ T _____ R _____

Joan Hall
REG. DEEDS

Register of Deeds Stamp & File Number

- 4. Lot No. _____, Recorded Plat _____
- 5. Private Claims _____

	A	B	C	D	E	F	G	H	I	J	K	L	M
2	6	5	4	3	2	1							
3													
4	7	8	9	10	11	12							
5													
6	18	17	16	15	14	13							
7													
8	19	20	21	22	23	24							
9													
10	30	29	28	27	26	25							
11													
12	31	32	33	34	35	36							
13													

I, EUGENE FARRIER, in a field survey on Nov. 14, 1996, do hereby certify that under requirements of P.A. 74, Michigan P.A. of 1970, the corner points mentioned in lines 1 and 2 above were in conformance with regulations and rules therefore as required in the current manual of survey instructions of the United States Department of the Interior, Bureau of Land Management or by a decree of a Court of Law and/or that the corner points mentioned in lines 3, 4 and 5 above were in conformance with the rules of the Michigan Board of Land Surveyors or by a Decree of a Court of Law; established, re-established, monumented, re-monumented, recovered, found as expressed below:

NOTE: Not more than 4 corners, all in the same town and range, may be recorded on this certificate.

A. Description of original monument and accessories and/or subsequent restoration:

G-02 cor common to Sec. 3 & 4, T26N-R6W, Oliver Township
1852, GLO resurvey, Set Post. 8"B. Ash N20W 14, 12"Cedar S36E 24.
08-21-1957, K.J.Ostling, used corner, w/ accessories.
09-21-1959, D.N.R., fd square stake, set 1" pipe w/ brass cap, w/ accessories.
08-22-1990, LCRC Liber 2 pg. 423.
05-11-1992, E.D.Farrier, Survey #7392, fd DNR mon, w/ accessories.

B. Description of corner evidence found and/or method applied in restoring or reestablishing corner:

G-02 cor common to Sec. 3 & 4, T26N-R6W, Oliver Township
Found DNR Mon w/ 4" x 4" Cedar Post w/ accessories. No G.L.O. witnesses found. The Kalkaska Co. peer group approved & accepted the above monument as a careful and faithful perpetuation of the position of the original corner.


Ratified by Peer Group
P.A. 345 - 1990 Kalkaska County

Chairman *Eugene Farrier*

Date 1-21-97

C. Description of monument for corner and accessories established to perpetuate locating the position of the corner:

G-02 cor common to Sec. 3 & 4, T26N-R6W, Oliver Township
Found DNR Mon w/ 4" x 4" Cedar Post w/ accessories.
Found nail S08E 14" Ash, 13.73'
Found nail S84W 12" Cedar, 28.13'
Found nail N28W 12" Tw. Ash, 8.05'
Found nail S65E 5" Balsam, 23.10'

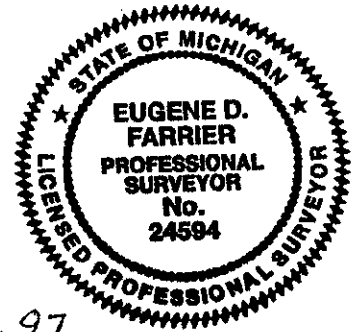

Signed by *Eugene Farrier*

Date 1-30-97

Surveyor's Michigan License No. 24594