

**SURVEY & REMONUMENTATION**

MAR 21 1997

COMMISSION

KALKASKA COUNTY, MICHIGAN RECEIVED

97 JAN 31 PM 2:45

**LAND CORNER RECORDATION CERTIFICATE**  
Filing Requirement of Act 74, Mich. P.A. 1970

For corners in

KALKASKA

(County)

Located In:

Corner Code #/

*Joan Hall*  
REG. OF DEEDS

1996 REMONUMENTATION

- |                                    |   |            |   |           |       |
|------------------------------------|---|------------|---|-----------|-------|
| 1. Public Land Survey              | T | <u>26N</u> | R | <u>6W</u> | G-3   |
|                                    | T | _____      | R | _____     | _____ |
|                                    | T | _____      | R | _____     | _____ |
|                                    | T | _____      | R | _____     | _____ |
| 2. Property Controlling in Section | S | _____      | T | _____     | R     |
|                                    | S | _____      | T | _____     | R     |
| 3. Miscellaneous Property in Sec.  | S | _____      | T | _____     | R     |
|                                    | S | _____      | T | _____     | R     |

Register of Deeds Stamp & File Number

4. Lot No. \_\_\_\_\_, Recorded Plat \_\_\_\_\_
5. Private Claims \_\_\_\_\_

	A	B	C	D	E	F	G	H	I	J	K	L	M
2	6		5		4		3		2		1		
3							●						
4	7		8		9		10		11		12		
5													
6	18		17		16		15		14		13		
7													
8	19		20		21		22		23		24		
9													
10	30		29		28		27		26		25		
11													
12	31		32		33		34		35		36		
13													

I, EUGENE FARRIER, in a field survey on Sept. 27, 1996, do hereby certify that under requirements of P.A. 74, Michigan P.A. of 1970, the corner points mentioned in lines 1 and 2 above were in conformance with regulations and rules therefore as required in the current manual of survey instructions of the United States Department of the Interior, Bureau of Land Management or by a decree of a Court of Law and/or that the corner points mentioned in lines 3, 4 and 5 above were in conformance with the rules of the Michigan Board of Land Surveyors or by a Decree of a Court of Law; established, re-established, monumented, re-monumented, recovered, found as expressed below:

**NOTE: Not more than 4 corners, all in the same town and range, may be recorded on this certificate.**

A. Description of original monument and accessories and/or subsequent restoration:

- G-03 cor common to Sec. 3, 4, 9 & 10, T26N-R6W, Oliver Township 1852, GLO resurvey, Set Post. 12" B. Ash S16E 15, 6" B. Ash N25W 29.
- 09-10-1880, G.A. Limpert, used corner, no accessories.
- 06-20-1881, E. Mosher, Co. Surveyor, used corner, no accessories.
- 09-25-1959, D.N.R., set 1" pipe w/ 4" brass cap, w/ accessories.
- 10-31-1988, LCRC Liber 2 pg. 368.
- 05-11-1992, E.D. Farrier, Survey #7392, fd 1" pipe w/ brass cap, w/ accessories.

B. Description of corner evidence found and/or method applied in restoring or reestablishing corner:


G-03 cor common to Sec. 3, 4, 9 & 10, T26N-R6W, Oliver Township Found DNR Mon on 1" iron pipe w/ accessories 8' North of c/l of Kniss Road, left Mon in place. No G.L.O. witnesses were found. The Kalkaska Co. peer group approved & accepted the above monument as a careful and faithful perpetuation of the position of the original corner.

Ratified by Peer Group  
P.A. 345 - 1990 Kalkaska County

Chairman Eugene Farrier  
Date 1-21-97

C. Description of monument for corner and accessories established to perpetuate locating the position of the corner:

- G-03 cor common to Sec. 3, 4, 9 & 10, T26N-R6W, Oliver Township Found DNR Mon on 1" iron pipe w/ accessories 8' North of c/l of Kniss Road, left Mon in place.
- Set nail & tag S16W 12" Cedar, 64.03' (old DNR).
- Set nail & tag N49W 10" Spruce, 47.75' (old DNR).
- Set nail & tag N05W 6" Tw. Cedar, 28.61' (old DNR).
- Set nail & tag N22E 12" Cedar, 49.63' (old DNR).

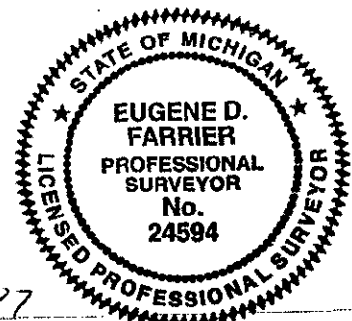

Signed by Eugene Farrier  
Surveyor's Michigan License No. 24594

Date 1-30-97