

MICHIGAN  
DEPARTMENT OF CONSERVATION  
FORESTRY DIVISION

LAND CORNER RECORD

T. 26 NR. 6 W. . . . .

Kalkaska COUNTY

DESCRIPTION OF CORNER Section corner common to Sections 3-4-9-10

DESCRIPTION OF CORNER MONUMENT 1" pipe with 4" brass cap

WITNESSES TO CORNER


12" Elm	-	N32E	-	33 links
12" Elm	-	S35E	-	49 links

DESCRIPTION IN DETAIL AS TO HOW CORNER WAS LOCATED AND IDENTIFIED OR RESTORED.

This corner was established by Forestry Division survey crew while making a partial resurvey of this township. Set corner by double proportionate measurement between original corners  $\frac{1}{2}$  mile north,  $\frac{1}{2}$  mile east,  $\frac{1}{2}$  mile south, and 1 mile west. Original evidence gone in road construction. This point conforms acceptably for line north and east, but places  $\frac{1}{4}$  corner southabout 11 links out of line between section corners. An LES post is 34 links west and 12 links north, and another squared post sets 55 links south of the LES. A 2 $\frac{1}{2}$ " pipe for property corner is 34 links north and 2 east.

Corner was placed and witnessed September 24, 1959.

SURVEYORS SEAL

 

SIGNED Kenneth J. Wilkin  
REGISTERED LAND SURVEYOR

DATE 9/25/59