

Lansing ~ Forestry

KALKASKA Co.

# LAND CORNER RECORDATION CERTIFICATE

## FILING REQUIREMENT OF ACT 74, MICH. P.A.1970

| FOR CORNERS OF--:                          | LOCATED IN--:  | CORNER CODE NUMBER      |
|--|--|-------------------------|
| 1. PUBLIC LAND SURVEY _____                | T. <u>26</u> N. <del>S</del> R. <u>6</u> E. <del>W</del> | <u>G-11; H-11; I-11</u> |
| 2. PROPERTY CONTROLLING IN SECTION _____   | , T. _____ N. S., R. _____ E. W.                         | _____                   |
| 3. MISCELLANEOUS PROPERTY IN SECTION _____ | , T. _____ N. S., R. _____ E. W.                         | _____                   |
| 4. LOT NO. _____, RECORDED PLAT _____      |  |                         |
| 5. PRIVATE CLAIMS _____                    |  |                         |

REGISTER OF DEEDS STAMP AND FILING NUMBER

I, Carl F. Roser do hereby certify that under requirements of P.A. 74, Michigan P.A. of 1970, the corner points mentioned in lines 1 and 2 above (identified with circles on index code diagram - over) were, in a field survey on 2-9 1973, established, re-established, monumented, re-monumented, recovered or restored as expressed below and in conformance with regulations and rules therefore as required in the current manual of survey instructions of the United States Department of the Interior, Bureau of Land Management or by a decree of a court of law. Furthermore, that the corner points mentioned in lines 3, 4 and 5 above were, in a field survey on \_\_\_\_\_ 19\_\_\_\_, found, recovered, restored, established or re-established as expressed below and in conformance with the rules of the Michigan State Board of Registration for Land Surveyors or, by a Decree of a Court of law:

A. Description of original monument and accessories and/or subsequent restoration:

B. Description of corner evidence found and/or method applied in restoring or re-establishing corner:

- G-11 Restored corner per Richards, Findorff, Richards Survey of Sec. 28 in 1964 ±.
- H-11 Reestablished corner per standard B.L.M. instructions.
- I-11 Previous Department corner of record.

C. Description of monument for corner and accessories established to perpetuate locating the position of the corner:

| G-11                        | H-11                         | I-11   |
|-----------------------------|------------------------------|--|
| Set DNR Mon w/Cedar Gd Post | Set DNR Mon. w/Cedar Gd Post | Recovered exist. Dept Mon w/Cedar Guard Post |
| 6" Cedar N35E 5.2           | 7" Balsam N 60 W 8.9         | 30" W. Pine stub S12W 40.1 (9' high)         |
| 9" Cedar S86E 19.5          | 6" Balsam S 01 W 21.2        | 28" W. Pine Stp. N 6E 59.5                   |
| 10" Cedar S 2E 40.3         | 7" Balsam N 50 E 31.5        | 16" Maple N55E 90.3                          |
| N-S Rand. Due E 2'          | E-W Rand. Due N 24.5         | 18" Oak S61E 91.7                            |
|                             |                              | 30" W. Pine Due N. 1.5'                      |


SIGNED BY Carl F. Roser DATE 6-23-73

SURVEYOR'S MICHIGAN REGISTRATION NO. 12028

FOR STATE AND UNITED STATES AGENCIES:

SIGNED BY \_\_\_\_\_ DATE \_\_\_\_\_  
CHIEF OF SURVEY PARTY

APPROVED AND SIGNED BY \_\_\_\_\_ DATE \_\_\_\_\_  
MICHIGAN REGISTERED LAND SURVEYOR (SEAL)

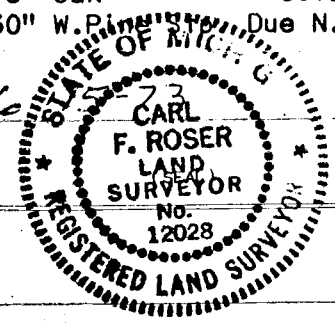

SURVEYOR'S MICHIGAN REGISTRATION NO. \_\_\_\_\_