

KALKASKA

# LAND CORNER RECORDATION CERTIFICATE

## FILING REQUIREMENT OF ACT 74, MICH. P.A.1970

FOR CORNERS OF--	LOCATED IN--	CORNER CODE NUMBER
1. PUBLIC LAND SURVEY	T. 26 N. 3 <del>4</del> R. 6 E. W.	C-1
2. PROPERTY CONTROLLING IN SECTION 6	T. 26 N. 3 <del>4</del> R. 6 E. W.	Code 2 Code 7
3. MISCELLANEOUS PROPERTY IN SECTION	T. S. R. E. W.	
4. LOT NO. _____, RECORDED PLAT _____		
5. PRIVATE CLAIMS _____		

REGISTER OF DEEDS STAMP AND FILING NUMBER

I, Carl F. Roser do hereby certify that under requirements of P.A. 74, Michigan P.A. of 1970, the corner points mentioned in lines 1 and 2 above (identified with circles on index code diagram - over) were, in a field survey on 10-24 1972, established, re-established, monumented, re-monumented, recovered or restored as expressed below and in conformance with regulations and rules therefore as required in the current manual of survey instructions of the United States Department of the Interior, Bureau of Land Management or by a decree of a court of law. Furthermore, that the corner points mentioned in lines 3, 4 and 5 above were, in a field survey on \_\_\_\_\_ 19\_\_\_\_, found, recovered, restored, established or re-established as expressed below and in conformance with the rules of the Michigan State Board of Registration for Land Surveyors or, by a Decree of a Court of law:

A. Description of original monument and accessories and/or subsequent restoration:

B. Description of corner evidence found and/or method applied in restoring or re-establishing corner:

- C-1 Restored corner in center of N-S gravel road in line with fence to East
- 2 Established corner per Standard B.L.M. instructions.
- 7 Established corner per standard B.L.M. instructions.

C. Description of monument for corner and accessories established to perpetuate locating the position of the corner:

C-1	Code 2	Code 7
Set D.N.R. Monument	Set 1"x5" pipe & Cedar	Set 1"x18" pipe in Ctr.
12" W.Pine N10W 154.55'	Gd. Post w/loc tag	of N-S Gravel Rd.
20" W.Pine N31E 152.11	9" Maple N65E 8.7'	7" W. Pipe N44W 73.08
20" W. Pine S25E 160.67	7" Maple N15W 25.3'	P.Pole N17E 105.61
Set Ced.Post	7" Tw Maple S11 W 25.1	9" Maple N79E 67.26
w/loc.tag Due W 33'	E-W Rand Due N 0.5'	Set Ced.post
Cor.Fn.Post Due E 31'		w/loc tag Due W 33'

SIGNED BY Carl F. Roser DATE 12-11-73

SURVEYOR'S MICHIGAN REGISTRATION NO. 12028


FOR STATE AND UNITED STATES AGENCIES:

SIGNED BY \_\_\_\_\_ DATE \_\_\_\_\_

CHIEF OF SURVEY PARTY

APPROVED AND SIGNED BY \_\_\_\_\_ DATE \_\_\_\_\_

MICHIGAN REGISTERED LAND SURVEYOR

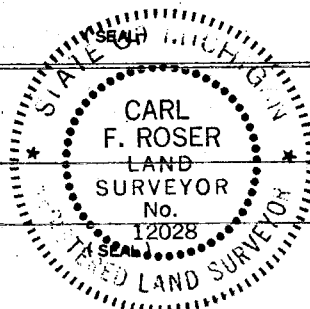

SURVEYOR'S MICHIGAN REGISTRATION NO. \_\_\_\_\_