

Lansing ~ Forestry

KALKASKA Co.

LAND CORNER RECORDATION CERTIFICATE

FILING REQUIREMENT OF ACT 74, MICH. P.A.1970

| FOR CORNERS OF--: | LOCATED IN--: | CORNER CODE NUMBER |
|--|------------------------------------|--------------------|
| 1. PUBLIC LAND SURVEY _____ | T. 26 N. S., R. 6 XX W. | G-12; 1-12 |
| 2. PROPERTY CONTROLLING IN SECTION <u>34</u> | T. 26 N. S., R. 6 XX W. | 1; 7 |
| 3. MISCELLANEOUS PROPERTY IN SECTION _____ | T. _____ N. S., R. _____ E. W. | |
| 4. LOT NO. _____, RECORDED PLAT _____ | | |
| 5. PRIVATE CLAIMS _____ | | |

REGISTER OF DEEDS STAMP AND FILING NUMBER

I, Carl F. Roser do hereby certify that under requirements of P.A. 74, Michigan P.A. of 1970, the corner points mentioned in lines 1 and 2 above (identified with circles on index code diagram - over) were, in a field survey on 2-9 1973, established, re-established, monumented, re-monumented, recovered or restored as expressed below and in conformance with regulations and rules therefore as required in the current manual of survey instructions of the United States Department of the Interior, Bureau of Land Management or by a decree of a court of law. Furthermore, that the corner points mentioned in lines 3, 4 and 5 above were, in a field survey on _____ 19____, found, recovered, restored, established or re-established as expressed below and in conformance with the rules of the Michigan State Board of Registration for Land Surveyors or, by a Decree of a Court of law:

A. Description of original monument and accessories and/or subsequent restoration:

C. Description of monument, etc.

Code 7
 Set 1"x36" Pipe w/Cedar Gd Post w/loc tag
 6" Twin Maple N44E 49.83
 24" Oak S69E 17.43'
 3" R. Pine S75W 49.10'

B. Description of corner evidence found and/or method applied in restoring or re-establishing corner:

- G-12 Reestablished corner per Std. B.L.M. instructions.
- 1-12 Recovered Fargo Pipe (1913) from one Fargo Witness and one U.S. Witness.
- 1 Established corner per standard B.L.M. instructions.
- 7 Established corner per Standard BLM instructions.


C. Description of monument for corner and accessories established to perpetuate locating the position of the corner:

| G-12 | 1-12 | Code 1 |
|-----------------------------|---------------------------|-----------------------------|
| Set DNR Mon w/Cedar Gd Post | Fd. Fargo Pipe. Added DNR | Set 1 1/4"x54" Pipe w/Cedar |
| 9" B. Cherry N12E 40.5' | Mon. w/Cedar Gd. Post | Guard Post w/loc tag |
| 9" B. Cherry S83W 77.0' | 5" W. Pine S84E 10.3' | 8" Cedar S51W 29.5' |
| Ctr E-W trail rd Due N 28'± | 6" R. Pine S43E 8.9' | 9" Cedar N41W 45.2 |
| (on curve) | 5" R. Pine Due N 67.1' | 7" Cedar N46E 47.7' |
| N-S Random Due W15.1' | C.Ln E-W sand rd " N 12' | E-W Rand N46E 36.5' |
| | N S Rand. Due E 25' | |

SIGNED BY Carl F. Roser

DATE 6-7-75

SURVEYOR'S MICHIGAN REGISTRATION NO. _____

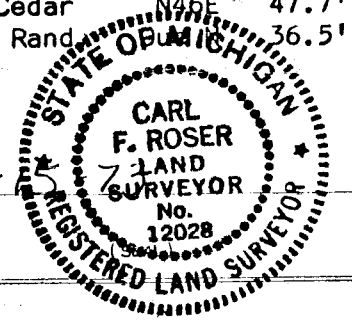

FOR STATE AND UNITED STATES AGENCIES:

SIGNED BY _____ DATE _____
CHIEF OF SURVEY PARTY

APPROVED AND SIGNED BY _____ DATE _____
MICHIGAN REGISTERED LAND SURVEYOR (SEAL)

SURVEYOR'S MICHIGAN REGISTRATION NO. _____