

MICHIGAN
DEPARTMENT OF CONSERVATION
FORESTRY DIVISION

LAND CORNER RECORD

T. 26 NR. 6 W

Kalkaska COUNTY


DESCRIPTION OF CORNER Section corner common to Sections 16, 17, 20, 2
DESCRIPTION OF CORNER MONUMENT 1"x24" pipe, below surface of road
WITNESSES TO CORNER

<u>Power pole stub</u>	<u>N 28 E</u>	<u>58 links</u>
<u>Power pole</u>	<u>N 47 W</u>	<u>73 links</u>
<u>8" Cedar</u>	<u>S 5 E</u>	<u>56 links</u>

DESCRIPTION IN DETAIL AS TO HOW CORNER WAS LOCATED AND IDENTIFIED OR RESTORED.

This corner was established by proportionate measurement by Forestry Division survey crew while making a partial resurvey of this township. Corner was placed at intersection of straight lines over 1/4 and section corner west and 1/4 and section corner north, which were established in a previous survey and are apparently of long standing. Checks for measurement in both directions. Could locate no existing corner but there is considerable road fill at this point. Corner falls in line with road north.

Corner was placed and witnessed 8/19/57.

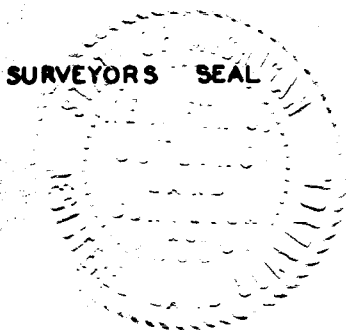

SIGNED *Harold J. Ostling*
REGISTERED LAND SURVEYOR

DATE 3/19/59