


LAND CORNER RECORDATION CERTIFICATE
Filing Requirement of Act 74, Mich. PA 1970

For Corners In:
Kalkaska Located In Corner Code #
(County)

1. Public Land Survey	T	<u>26N</u>	R	<u>6W</u>	<u>M9</u>
	T	<u>26N</u>	R	<u>5W</u>	<u>A9</u>
2. Property Controlling in Section	S	_____	T	_____	R
	S	_____	T	_____	R
3. Miscellaneous Property in Section	S	_____	T	_____	R
	S	_____	T	_____	R

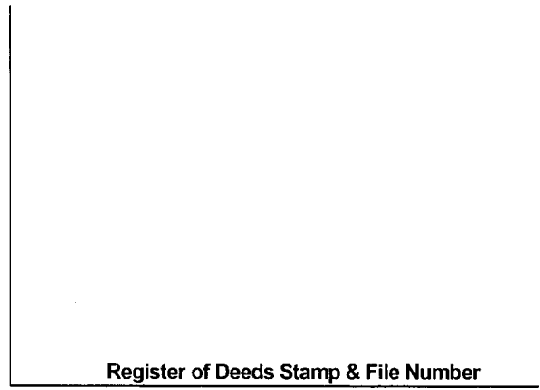


4. Lot No: _____ Recorded Plat: _____

5. Private Claims: _____

I, Craig W. McVean, in a field survey on Feb. 9, 2009 do hereby state that under requirements of PA 74, Michigan PA of 1970, the corner points mentioned in lines 1 and 2 above were in conformance with regulations and rules therefore as required in the current manual of survey instructions of the United States Department of the Interior, Bureau of Land Management or by a decree of a Court of Law and/or that the corner points mentioned in lines 3, 4 and 5 above were in conformance with the rules of the Michigan Board of Land Surveyors or by a Decree of a Court of Law; established, re-established, monumented, recovered, found as expressed below:

NOTE: Not more than 2 corners, all in the same town and range, may be recorded on this certificate.

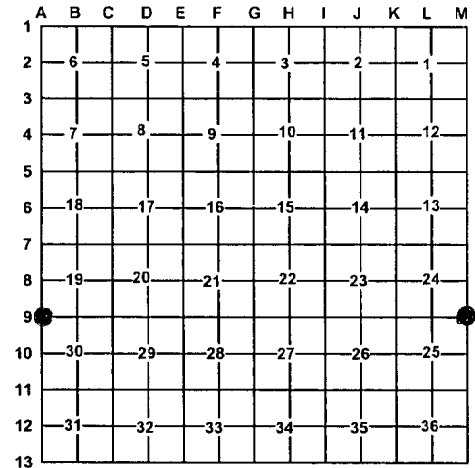

A. Description of original monument and accessories and/or subsequent restoration:

- M9-A9 – 1839 – GLO – J. Mullett – Set post Sec. 24 & 25
- 1) Cedar 10" N66°W 17 L.
 - 2) Cedar 10" S36°W 14 L.
 - 1852 – GLO – T26N, R5W – G. Cannon
 - 3) Cedar 6" S26°E 18 L.
 - 4) Cedar 6" N67°E 8 L.
 - 1913 – Fargo Eng. – No US evidence
 - Set Temporary corner only
 - 1939 – M. Schaaf notes indicated he chained by corner.
 - Nothing conclusive noted.
 - 1975 – LCRC L. 1, p. 363-A; H. L. Fluharty
 - Fd. 3/8" iron with cap in swamp approx. 20' W. of brushed line N & S

- 5) 12" Tw. Birch N60°E 27.31'; 6) 7: Birch S30°W 7.15'; 7) 7" Birch S45°E 26.01'
- 1978 – Consumer Power Co. – Drawing #S-F 17406
- Sheet 9 – Fd. reroed and cap #12026
- 5) 10" Birch N60°E 27.34'
- 8) 5" Birch S57°W 26.03'
- 6) 6" Birch S30°W 7.15'
- 9) 7" Birch N3°W 9.30'

B. Description of corner evidence found and/or method applied in restoring or re-establishing corner:

M9-A9 – Standard Corner common to Section 24 & 25, T26N, R6W and Sections 19 & 30, T26N, R5W – Fd. 1/2" x 18" rebar with broken cap per Fluharty & Consumers. This iron was set by C. E. Ostling probably in 1972 for survey done in Sec. 24. Apparently set by single proportion to GLO between corners 'M11-A11' and 'M7-A7'. We measure grid bearings and distance of S0°33'42"W 5255.75' (5280' – GLO) to 'M11-A11' and N0°33'32"E 5254.55' (5280' – GLO) to 'M7-A7'. This 1/2" CIR fits remains of witness #9 and dead snag of #8. All other witnesses are gone. 1/2" capped rebar accepted as a careful and faithful reestablishment of the position of the original corner.

C. Description of monument for corner and accessories established to perpetuate locating the position of the corner:

M9-A9 – Drove stamped 4" DNR Alum. Cap on 1" x 5' long galv. iron pipe over top of fd. 1/2" CIR – Up 1'
Set Blue Carsonite Post 1' North
S25°W 44.85' to set N & T in W. side 12" R. Maple
N28°E 28.07' to set 1/2" x 24" rebar
S52°W 25.56' to set 1/2" x 24" smooth iron rod
N32°W 33.54' to set 1/2" x 18" rebar



Signed by: Craig W. McVean
Surveyor's Michigan License No.: 39088

Date: 11/23/2009