

# SURVEY & REMONUMENTATION

FEB 13 1998

## SECTION

## LAND CORNER RECORDATION CERTIFICATE Filing Requirement of Act 74, Mich. P.A. 1970

For corners in

|                                       |                          |               |  |
|---------------------------------------|--------------------------|---------------|--|
| <u>KALKASKA</u>                       | Located In:              | Corner Code # |  |
| (County)                              |                          |               |  |
| 1997 REMONUMENTATION                  |                          |               |  |
| 1. Public Land Survey                 | T <u>26N</u> R <u>7W</u> | <u>A-4</u>    |  |
|                                       | T _____ R _____          | _____         |  |
|                                       | T _____ R _____          | _____         |  |
|                                       | T _____ R _____          | _____         |  |
| 2. Property Controlling<br>in Section | S _____ T _____ R _____  | _____         |  |
|                                       | S _____ T _____ R _____  | _____         |  |
| 3. Miscellaneous<br>Property in Sec.  | S _____ T _____ R _____  | _____         |  |
|                                       | S _____ T _____ R _____  | _____         |  |

Register of Deeds Stamp & File Number

4. Lot No. \_\_\_\_\_, Recorded Plat \_\_\_\_\_

5. Private Claims \_\_\_\_\_

|    |    |   |    |   |    |   |    |   |    |   |    |   |   |
|----|----|---|----|---|----|---|----|---|----|---|----|---|---|
|    | A  | B | C  | D | E  | F | G  | H | I  | J | K  | L | M |
| 1  |    |   |    |   |    |   |    |   |    |   |    |   |   |
| 2  | 6  |   | 5  |   | 4  |   | 3  |   | 2  |   | 1  |   |   |
| 3  |    |   |    |   |    |   |    |   |    |   |    |   |   |
| 4  | 7  |   | 8  |   | 9  |   | 10 |   | 11 |   | 12 |   |   |
| 5  |    |   |    |   |    |   |    |   |    |   |    |   |   |
| 6  | 18 |   | 17 |   | 16 |   | 15 |   | 14 |   | 13 |   |   |
| 7  |    |   |    |   |    |   |    |   |    |   |    |   |   |
| 8  | 19 |   | 20 |   | 21 |   | 22 |   | 23 |   | 24 |   |   |
| 9  |    |   |    |   |    |   |    |   |    |   |    |   |   |
| 10 | 30 |   | 29 |   | 28 |   | 27 |   | 26 |   | 25 |   |   |
| 11 |    |   |    |   |    |   |    |   |    |   |    |   |   |
| 12 | 31 |   | 32 |   | 33 |   | 34 |   | 35 |   | 36 |   |   |
| 13 |    |   |    |   |    |   |    |   |    |   |    |   |   |

I, EUGENE FARRIER, in a field survey on AUGUST 8, 1997 do hereby state that under requirements of P.A. 74, Michigan P.A. of 1970, the corner points mentioned in lines 1 and 2 above were in conformance with regulations and rules therefore as required in the current manual of survey instructions of the United States Department of the Interior, Bureau of Land Management or by a decree of a Court of Law and /or that the corner points mentioned in lines 3, 4 and 5 above were in conformance with the rules of the Michigan Board of Land Surveyors or by a Decree of a Court of Law; established, re-established, monumented, recovered, found as expressed below:


**NOTE:** Not more than 2 corners, all in the same town and range, may be recorded on this certificate.

A. Description of original monument and accessories and/or subsequent restoration:

A-4: West 1/4 Cor. Sec. 7, T26N-R7W, Orange Township  
01-29-1988, Farrier Surveying, Cert. Survey, set 1/2" iron Lib. 3, Pg. 475, LCR, set 1/2" iron Lib. 2, Pg. 381, w/accessories

B. Description of corner evidence found and/or method applied in restoring or reestablishing corner:

A-4: West 1/4 Cor. Sec. 7, T26N-R7W, Orange Township  
Fd. 1/2" x 18" rebar w/cap #24594 w/accessories in C.L. trail rd., Pulled & replaced with 5/8" x 18" rebar w/brass cap. No GLO witnesses were fd. The Kalkaska Co. Peer group approved & accepted the above monument. This position not established by original government surveyors. This monument is accepted as the best available evidence of the position of the corner.

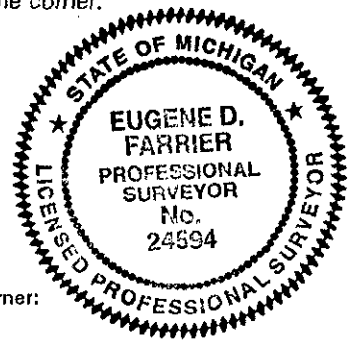

C. Description of monument for corner and accessories established to perpetuate locating the position of the corner:

A-4: West 1/4 Cor. Sec. 7, T26N-R7W, Orange Township  
Fd. 1/2" x 18" rebar w/cap #24594 w/accessories in C.L. trail rd., Pulled & replaced with 5/8" x 18" rebar w/brass cap.  
5/8" rerod and remon. brass cap North, 56.02' (Standard corner)  
Set nail & tag N52E 8" W. Pine 44.61'  
Fd. Nail S61E 7" R. Pine 44.48'  
Set nail & tag West 18" Maple 25.75'  
Set nail & tag N47W 16" Tw. Birch 50.32

**Ratified by Peer Group**  
**P.A. 345 - 1990 Kalkaska County**  
Chairman Eugene Farrier  
Date 1-29-98

Signed by Eugene Farrier  
Michigan License No. 24594

Date 2-3-98 Surveyor's



**3004810**  
Page: 1 of 1  
02/04/98 11:22A  
Kalkaska County REMON 9.00 LB: 5 PG: 214