

**SURVEY &
REMONUMENTATION**

FEB 13 1998

SECTION

**LAND CORNER RECORDATION CERTIFICATE
Filing Requirement of Act 74, Mich. P.A. 1970**

For corners in

KALKASKA Located In: Corner Code #
(County)
1997 REMONUMENTATION
1. Public Land Survey T 26N R 7W A-6
T _____ R _____
T _____ R _____
T _____ R _____
2. Property Controlling S _____ T _____ R _____
in Section S _____ T _____ R _____
3. Miscellaneous S _____ T _____ R _____
Property in Sec. S _____ T _____ R _____

Register of Deeds Stamp & File Number

4. Lot No. _____, Recorded Plat _____

5. Private Claims _____


I, EUGENE FARRIER, in a field survey on AUGUST 8, 1997
do hereby state that under requirements of P.A. 74, Michigan P.A. of 1970, the corner points mentioned in lines 1 and 2 above were in conformance with regulations and rules thereof as required in the current manual of survey instructions of the United States Department of the Interior, Bureau of Land Management or by a decree of a Court of Law and /or that the corner points mentioned in lines 3, 4 and 5 above were in conformance with the rules of the Michigan Board of Land Surveyors or by a Decree of a Court of Law; established, re-established, monumented, recovered, found as expressed below:

NOTE: Not more than 2 corners, all in the same town and range, may be recorded on this certificate.

	A	B	C	D	E	F	G	H	I	J	K	L	M
1													
2	6		5		4		3		2		1		
3													
4	7		8		9		10		11		12		
5													
6	18		17		16		15		14		13		
7													
8	19		20		21		22		23		24		
9													
10	30		29		28		27		26		25		
11													
12	31		32		33		34		35		36		
13													

A. Description of original monument and accessories and/or subsequent restoration:
A-6: West 1/4 Cor. Sec. 18, T26N-R7W, Orange Township
09-19-1984, Farrier Surveying, Cert. Survey #8684B, Set 1/2" iron & cap at S.P.D., w/accessories
04-29-1993, Grand Traverse Survey Co., Cert. Survey, fd. 1/2" iron, w/ accessories, Lib. 4, Pg. 281

B. Description of corner evidence found and/or method applied in restoring or reestablishing corner:
A-6: West 1/4 Cor. Sec. 18, T26N-R7W, Orange Township
Fd. 1/2" x 18" rebar w/cap. Could not read No. On cap, in C.L. Puffer Rd. Pulled & replaced with 5/8" x 18" rebar w/brass cap. No GLO witnesses were fd. The Kalkaska Co. Peer group approved & accepted the above monument. This position not established by original government surveyors. This monument is accepted as the best available evidence of the position of the corner.

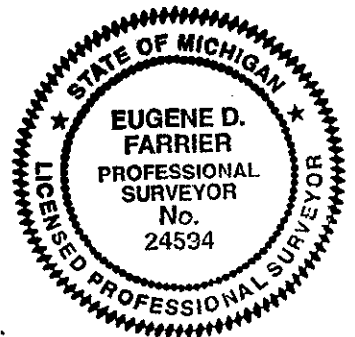

C. Description of monument for corner and accessories established to perpetuate locating the position of the corner:
A-6: West 1/4 Cor. Sec. 18, T26N-R7W, Orange Township
Fd. 1/2" x 18" rebar w/cap. Could not read No. On cap, in C.L. Puffer Rd. Pulled & replaced with 5/8" x 18" rebar w/brass cap.
North Kalkaska Co. Mon. 20.80' (Standard corner)
Fd. Nail N65E 10" Maple 22.12'
Fd. Nail S49E 10" Maple 36.80'
Fd. Nail N69W 14" Beech 22.87'

Ratified by Peer Group
P.A. 345 - 1990 Kalkaska County
Chairman Eugene Farrier
Date 7-29-98

Signed by Eugene Farrier
Surveyor's Michigan License No. 24594

Date 2-3-98



3004812
Page: 1 of 1
02/04/98 11:22A
Kalkaska County REMON 9 00 I.B. 5 PG. 216