

**SURVEY &
REMONUMENTATION**

FEB 13 1998

SECTION

**LAND CORNER RECORDATION CERTIFICATE
Filing Requirement of Act 74, Mich. P.A. 1970**

For corners in

<u>KALKASKA</u>	Located In:	Corner Code #
(County)		
1997 REMONUMENTATION		
1. Public Land Survey	<u>T.26N R.7W</u>	<u>A-10</u>
	T.____ R.____	_____
	T.____ R.____	_____
	T.____ R.____	_____
2. Property Controlling	S.____ T.____ R.____	_____
in Section	S.____ T.____ R.____	_____
3. Miscellaneous	S.____ T.____ R.____	_____
Property in Sec.	S.____ T.____ R.____	_____

Register of Deeds Stamp & File Number

4. Lot No. _____, Recorded Plat _____

5. Private Claims _____

	A	B	C	D	E	F	G	H	I	J	K	L	M
1													
2	6		5		4		3		2		1		
3													
4	7		8		9		10		11		12		
5													
6	18		17		16		15		14		13		
7													
8	19		20		21		22		23		24		
9													
10	30		29		28		27		26		25		
11													
12	31		32		33		34		35		36		
13													


I, EUGENE FARRIER, in a field survey on OCTOBER 28, 1997 do hereby state that under requirements of P.A. 74, Michigan P.A. of 1970, the corner points mentioned in lines 1 and 2 above were in conformance with regulations and rules therefore as required in the current manual of survey instructions of the United States Department of the Interior, Bureau of Land Management or by a decree of a Court of Law and /or that the corner points mentioned in lines 3, 4 and 5 above were in conformance with the rules of the Michigan Board of Land Surveyors or by a Decree of a Court of Law; established, re-established, monumented, recovered, found as expressed below:

NOTE: Not more than 2 corners, all in the same town and range, may be recorded on this certificate.

A. Description of original monument and accessories and/or subsequent restoration:
A-10: West 1/4 Cor. Sec. 30, T26N-R7W, Orange Township
 02-22-1980, N.F. Parker #16939, Survey, used cor., w/accessories, Lib. 2, Pg. 544
 02-22-1980, N.F. Parker #16939, LCR, Fd. 3/4" pipe, w/accessories, Lib. 2, 204

B. Description of corner evidence found and/or method applied in restoring or reestablishing corner:
A-10: West 1/4 Cor. Sec. 30, T26N-R7W, Orange Township
 Fd. 3/4" pipe 5' West of C.L. Puffer Rd. 23' South of C.L. farm lane to East and 0.10' E. of Standard line. Set 5/8" rebar w/brass cap in pipe, in mon. Box. No GLO witnesses were fd. The Kalkaska Co. Peer group approved & accepted the above monument. This position not established by original government surveyors. This monument is accepted a the best available evidence of the position of the corner.

Ratified by Peer Group
 P.A. 345 - 1990 Kalkaska County
 Chairman Eugene Farrier
 Date 1-29-98

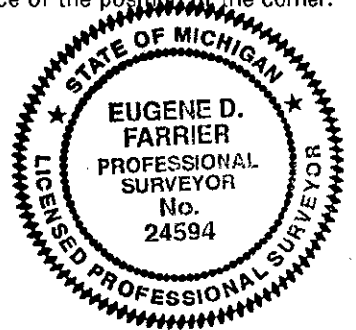

C. Description of monument for corner and accessories established to perpetuate locating the position of the corner:
A-10: West 1/4 Cor. Sec. 30, T26N-R7W, Orange Township
 Fd. 3/4" pipe 5' West of C.L. Puffer Rd. 23' South of C.L. farm lane to East set 5/8" rebar w/brass cap in pipe, in mon. Box.
 Set nail S51W, tele box post, 41.09'
 Fd. N06E, 1/2" iron, 164.21' (Standard corner)
 Fd. S79E plat conc. Mon., 65.3'
 Fd. S49E tele box & post, 50.60'

Signed by Eugene Farrier Date 2-3-98
 Surveyor's Michigan License No. 24594



3004816
 Page: 1 of 1
 02/04/98 11:22A
 LB: 5 PG: 220