

# SURVEY & REMONUMENTATION

FEB 13 1998

## SECTION

### LAND CORNER RECORDATION CERTIFICATE Filing Requirement of Act 74, Mich. P.A. 1970

For corners in

<u>KALKASKA</u>	Located In:	Corner Code #	
(County)			
1997 REMONUMENTATION			
1. Public Land Survey	T <u>26N</u> R <u>7W</u>	A-11	
	T _____ R _____	_____	_____
	T _____ R _____	_____	_____
	T _____ R _____	_____	_____
2. Property Controlling in Section	S _____ T _____ R _____	_____	_____
	S _____ T _____ R _____	_____	_____
3. Miscellaneous Property in Sec.	S _____ T _____ R _____	_____	_____
	S _____ T _____ R _____	_____	_____

Register of Deeds Stamp & File Number

4. Lot No. \_\_\_\_\_, Recorded Plat \_\_\_\_\_

5. Private Claims \_\_\_\_\_

I, EUGENE FARRIER, in a field survey on OCTOBER 29, 1997 do hereby state that under requirements of P.A. 74, Michigan P.A. of 1970, the corner points mentioned in lines 1 and 2 above were in conformance with regulations and rules therefore as required in the current manual of survey instructions of the United States Department of the Interior, Bureau of Land Management or by a decree of a Court of Law and /or that the corner points mentioned in lines 3, 4 and 5 above were in conformance with the rules of the Michigan Board of Land Surveyors or by a Decree of a Court of Law; established, re-established, monumented, recovered, found as expressed below:

**NOTE: Not more than 2 corners, all in the same town and range, may be recorded on this certificate.**

	A	B	C	D	E	F	G	H	I	J	K	L	M
1													
2	6		5		4		3		2		1		
3													
4	7		8		9		10		11		12		
5													
6	18		17		16		15		14		13		
7													
8	19		20		21		22		23		24		
9													
10	30		29		28		27		26		25		
11													
12	31		32		33		34		35		36		
13													


A. Description of original monument and accessories and/or subsequent restoration:

A-11: Sec. Cor. Common to Sec. 30 & 31, T26N-R7W, Orange Township  
 1849, GLO resurvey, set Spruce post, 7" Spruce N32E, 44, 13" Tamarack S32W, 12  
 04-27-1901, W.S. Merrill, Co. Surveyor, used cor. W/accessories  
 05-20-1981, Farrier Surveying, LCR, Fd iron, raised w/nail, w/accessories, Lib. 2, Pg. 292  
 05-20-1981, Farrier Surveying, Cert. Survey, fd. Iron, raised w/nail, w/accessories, Lib 2, Pg. 627  
 05-30-1987, Farrier Surveying, Cert. Survey, fd. Conc. Mon., w/accessories

B. Description of corner evidence found and/or method applied in restoring or reestablishing corner:

A-11: Sec. Cor. Common to Sec. 30 & 31, T26N-R7W, Orange Township  
 Fd. Conc. Mon., 1' West of Puffer Rd. in C.L. of Montgomery Rd. to East, 0.13' West of Standard line. Set mon. box around conc. mon.  
 No GLO witnesses were fd. The Kalkaska Co. Peer group approved & accepted the above monument as a careful and faithful  
 reestablishment of the position of the original corner.

Ratified by Peer Group  
 P.A. 345 - 1990 Kalkaska County  
 Chairman Eugene Farrier  
 Date 1-29-98

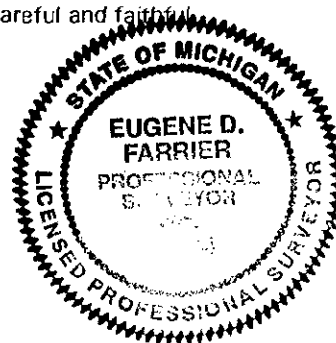

C. Description of monument for corner and accessories established to perpetuate locating the position of the corner:  
A-11: Sec. Cor. Common to Sec. 30 & 31, T26N-R7W, Orange Township  
 Fd. Conc. Mon., 1' West of Puffer Rd. in C.L. of Montgomery Rd. to East, set mon. box around conc. mon.  
 Fd. Nail, N18W, 7" J. Pine, 103.22'  
 Fd. Nail, N57E, P. Pole, 50.21'  
 Fd. Nail, S25W, 10" Tw. Tamarack, 56.40'  
 Fd. Kalkaska Co. Mon. N05E, 211.70' ( Standard corner)

Signed by Eugene Farrier Date 2-3-98  
 Surveyor's Michigan License No. 24594