

**SURVEY &
REMONUMENTATION**

FEB 13 1998

SECTION

**LAND CORNER RECORDATION CERTIFICATE
Filing Requirement of Act 74, Mich. P.A. 1970**

For corners in

<u>KALKASKA</u>	Located In:	Corner Code #
(County)		
1997 REMONUMENTATION		
1. Public Land Survey	T <u>26N</u> R <u>7W</u>	<u>B-9</u>
	T _____ R _____	_____
	T _____ R _____	_____
	T _____ R _____	_____
2. Property Controlling	S _____ T _____ R _____	_____
in Section	S _____ T _____ R _____	_____
3. Miscellaneous	S _____ T _____ R _____	_____
Property in Sec.	S _____ T _____ R _____	_____

Register of Deeds Stamp & File Number

4. Lot No. _____, Recorded Plat _____

5. Private Claims _____

	A	B	C	D	E	F	G	H	I	J	K	L	M
1													
2		6		5		4		3		2		1	
3													
4		7		8		9		10		11		12	
5													
6		18		17		16		15		14		13	
7													
8		19		20		21		22		23		24	
9		●											
10		30		29		28		27		26		25	
11													
12		31		32		33		34		35		36	
13													


I, EUGENE FARRIER, in a field survey on OCTOBER 24, 1997 do hereby state that under requirements of P.A. 74, Michigan P.A. of 1970, the corner points mentioned in lines 1 and 2 above were in conformance with regulations and rules therefore as required in the current manual of survey instructions of the United States Department of the Interior, Bureau of Land Management or by a decree of a Court of Law and /or that the corner points mentioned in lines 3, 4 and 5 above were in conformance with the rules of the Michigan Board of Land Surveyors or by a Decree of a Court of Law; established, re-established, monumented, recovered, found as expressed below:

NOTE: Not more than 2 corners, all in the same town and range, may be recorded on this certificate.

A. Description of original monument and accessories and/or subsequent restoration:
B-9: 1/4 cor. Common to Sec. 19 & 30, T26N-R7W Orange Twp.
 1849, GLO resurvey, set Beech post, 6" Beech N38E, 3, 13" Sugar S10W, 32
 02-22-1980, N.L. Parker #16939, Fd. 1/2" iron bar, w/accessories, Lib. 2, Pg. 544
 07-09-1982, Farrier Surveying, Cert. Survey, fd. 1/2" iron rod, w/accessories, Lib. 2, Pg. 813
 04-04-1987, Farrier Surveying, Cert. Survey, fd. 1/2" iron rod, w/accessories

B. Description of corner evidence found and/or method applied in restoring or reestablishing corner:
B-9: 1/4 cor. Common to Sec. 19 & 30, T26N-R7W Orange Twp.
 Fd 1/2" x 18" rebar, 8' North of C.L. Hall Rd. & on tree line to South. Pulled and replaced with 5/8" x 18" rebar, w/brass cap. No GLO witnesses were fd. The Kalkaska Co. Peer group approved and accepted the above monument as the best available evidence of the position of the original corner.

C. Description of monument for corner and accessories established to perpetuate locating the position of the corner:
B-9: 1/4 cor. Common to Sec. 19 & 30, T26N-R7W Orange Twp.
 Fd 1/2" x 18" rebar, 8' North of C.L. Hall Rd. & on tree line to South. Pulled and replaced with 5/8" x 18" rebar, w/brass cap.
 North, iron & cap #24594, 33.00'
 Set nail & tag S40E, 12" W. Pine, 50.11'
 South, 1/2" iron, 33.00'
 Set nail & tag S50W, 7" Tw. Cherry, 63.28'

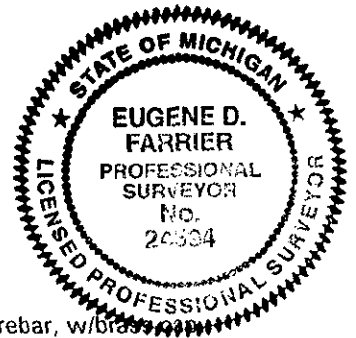

Ratified by Peer Group
 P.A. 345 - 1990 Kalkaska County
 Chairman Eugene Farrier
 Date 1-29-98

Signed by Eugene Farrier
 Surveyor's Michigan License No. 24594

Date 2-3-98



3004824
 Page: 1 of 1
 02/04/98 11:22A