

**SURVEY &
REMONUMENTATION**


FEB 13 1998

SECTION

**LAND CORNER RECORDATION CERTIFICATE
Filing Requirement of Act 74, Mich. P.A. 1970**

For corners in

<u>KALKASKA</u>	Located In:	Corner Code #
(County)		
1997 REMONUMENTATION		
1. Public Land Survey	T <u>26N</u> R <u>7W</u>	<u>B-13</u>
	<u>T25N</u> R <u>7W</u>	<u>B-1</u>
	T _____ R _____	_____
	T _____ R _____	_____
2. Property Controlling in Section	S _____ T _____ R _____	_____
	S _____ T _____ R _____	_____
3. Miscellaneous Property in Sec.	S _____ T _____ R _____	_____
	S _____ T _____ R _____	_____

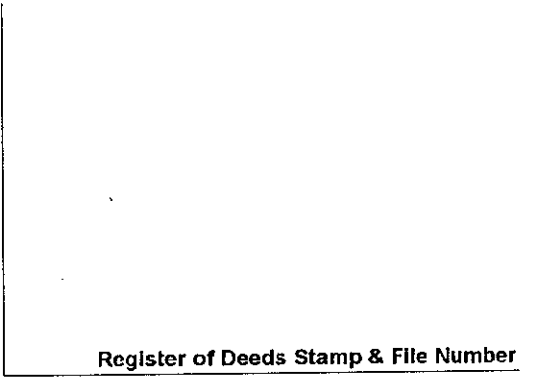

4. Lot No. _____, Recorded Plat _____

5. Private Claims _____


I, EUGENE FARRIER, in a field survey on OCTOBER 24, 1997 do hereby state that under requirements of P.A. 74, Michigan P.A. of 1970, the corner points mentioned in lines 1 and 2 above were in conformance with regulations and rules therefore as required in the current manual of survey instructions of the United States Department of the Interior, Bureau of Land Management or by a decree of a Court of Law and /or that the corner points mentioned in lines 3, 4 and 5 above were in conformance with the rules of the Michigan Board of Land Surveyors or by a Decree of a Court of Law; established, re-established, monumented, recovered, found as expressed below:

	A	B	C	D	E	F	G	H	I	J	K	L	M
1													
2	6		5		4		3		2		1		
3													
4	7		8		9		10		11		12		
5													
6	13		17		16		15		14		13		
7													
8	19		20		21		22		23		24		
9													
10	30		29		28		27		26		25		
11													
12	31		32		33		34		35		36		
13													

NOTE: Not more than 2 corners, all in the same town and range, may be recorded on this certificate.

A. Description of original monument and accessories and/or subsequent restoration:
B-13: 1/4 cor. Common to Sec. 31, T26N-R7W Orange Twp., Sec. 6, T25N-R7W, Garfield Twp. 1849, GLO resurvey, set post, 8" Beech N85W, 25, 10" Sugar N40E, 22 05-17-1971, J.F. Erickson #16929, LCR, fd. 1/2" pipe, w/accessories, Lib. 1, Pg. 37 04-08-1988, Farrier Surveying, Cert. Survey, fd. 1" pipe, w/accessories

B. Description of corner evidence found and/or method applied in restoring or reestablishing corner:
B-13: 1/4 cor. Common to Sec. 31, T26N-R7W Orange Twp., Sec. 6, T25N-R7W, Garfield Twp. Fd. 1" iron pipe 3' North of E-W 2-track & in line w/fence to North & 2' West of tree line to South. Pulled and replaced with 5/8" x 36" rebar, w/brass cap. No GLO witnesses were fd. The Kalkaska Co. Peer group approved and accepted the above monument as the best available evidence of the position of the original corner.

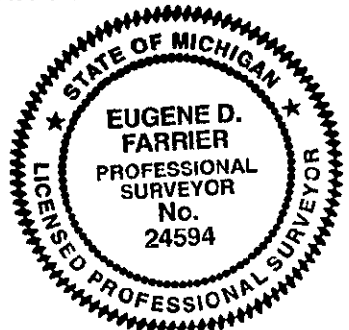

C. Description of monument for corner and accessories established to perpetuate locating the position of the corner:
B-13: 1/4 cor. Common to Sec. 31, T26N-R7W Orange Twp., Sec. 6, T25N-R7W, Garfield Twp. Fd. 1" iron pipe 3' North of E-W 2-track & of fence line to North & 2' West of tree line to South. Pulled and replaced with 5/8" x 36" rebar, w/brass cap.
 Set nail & tag N05E, 28" Tri. Maple, 68.50'
 Set nail & tag N81E, 7" Maple, 42.65'
 Set nail & tag S48E, 27" Maple, 54.25'
 Set nail & tag S05W, 24" Maple, 28.85'

Ratified by Peer Group
P.A. 345 - 1990 Kalkaska County
 Chairman Eugene Farrier
 Date 1-29-98

Signed by Eugene Farrier
 Surveyor's Michigan License No. 24594

Date 2-3-98



3004826
 Page: 1 of 1
 02/04/98 11:22A
 (R) 5 PG: 230