

SURVEY & REMONUMENTATION

MAR 21 1997

LAND CORNER RECORDATION CERTIFICATE
Filing Requirement of Act 74, Mich. P.A. 1970

KALKASKA COUNTY, MICHIGAN
RECEIVED

Joan Hall
REG. DEEDS

For corners in **COMMISSION**

KALKASKA
(County)

Located In:

Corner Code #

1996 REMONUMENTATION

- | | | |
|---------------------------------------|--------------------------|-------|
| 1. Public Land Survey | T <u>26N</u> R <u>7W</u> | C-1 |
| | T _____ R _____ | _____ |
| | T _____ R _____ | _____ |
| | T _____ R _____ | _____ |
| 2. Property Controlling in Section | S _____ T _____ R _____ | _____ |
| | S _____ T _____ R _____ | _____ |
| 3. Miscellaneous Property in Sec. | S _____ T _____ R _____ | _____ |
| | S _____ T _____ R _____ | _____ |
| 4. Lot No. _____, Recorded Plat _____ | | |
| 5. Private Claims _____ | | |

Register of Deeds Stamp & File Number

	A	B	C	D	E	F	G	H	I	J	K	L	M
2	6		5		4		3		2		1		
3													
4	7		8		9		10		11		12		
5													
6	18		17		16		15		14		13		
7													
8	19		20		21		22		23		24		
9													
10	30		29		28		27		26		25		
11													
12	31		32		33		34		35		36		
13													

I, EUGENE FARRIER, in a field survey on Oct. 2, 1996, do hereby certify that under requirements of P.A. 74, Michigan P.A. of 1970, the corner points mentioned in lines 1 and 2 above were in conformance with regulations and rules therefore as required in the current manual of survey instructions of the United States Department of the Interior, Bureau of Land Management or by a decree of a Court of Law and/or that the corner points mentioned in lines 3, 4 and 5 above were in conformance with the rules of the Michigan Board of Land Surveyors or by a Decree of a Court of Law; established, re-established, monumented, re-monumented, recovered, found as expressed below:


NOTE: Not more than 4 corners, all in the same town and range, may be recorded on this certificate.

- A. Description of original monument and accessories and/or subsequent restoration:
 C-01: Cor. common to Sec. 6 & 5, T26N-R7W, Orange Township 1849, GLO resurvey, set Beech post. 12" Beech S23W 38, 12" Beech S20E 48. Apr 13, 1905, W.S. Merrill, Co. Surveyor, used cor. no accessories. May 13, 1987, C.F. Roser, fd 1" pipe raised it w/ 3/8" Boat Spike w/ accessories. May 13, 1987, LCRC Liber 2 Pg. 345. 03-05-1990, E.D. Farrier, Survey #2886B, fd. 1" iron pipe no accessories. 07-31-1991, E.D. Farrier, Survey #6991, fd. 3/8" Boat spike w/ accessories. 07-06-1992, N.L. Way, fd 1" iron pipe w/ accessories. 05-12-1993, Farrier Surveying, fd. 1" Boat spike. Survey #6993

- B. Description of corner evidence found and/or method applied in restoring or reestablishing corner:
 C-01: Cor. common to Sec. 6 & 5, T26N-R7W, Orange Township Found Boat Spike and 1" x 32" pipe w/ accessories. Pulled & Set 5/8" x 18" re-rod w/ Brass cap in mon box in centerline of Thomas Road & centerline of Prough Road to South. No G.L.O. witnesses were found. The Kalkaska Co. peer group approved & accepted the above monument as a careful and faithful perpetuation of the position of the original corner.

Ratified by Peer Group
P.A. 345 - 1990 Kalkaska County
 Chairman Eugene Farrier
 Date 11-21-97

- C. Description of monument for corner and accessories established to perpetuate locating the position of the corner:
 C-01: Cor. common to Sec. 6 & 5, T26N-R7W, Orange Township Found Boat Spike and 1" x 32" pipe w/ accessories. Pulled & Set 5/8" x 18" re-rod w/ Brass cap in mon box in centerline of Thomas Road & centerline of Prough Road to South. Set nail & tag N17W 10" R. Pine, 37.48' (old wit) Set nail & tag N47E 11" Tw. Maple, 37.25' (old wit) Set nail & tag S58W 30" Maple, 66.92' (old wit) East Kal. Co. Mon. sec. 31 & 32, 74.58'

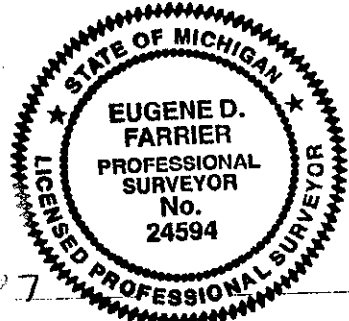

Signed by Eugene Farrier
 Surveyor's Michigan License No. 24594

Date 1-31-97