

SURVEY & REMONUMENTATION

MAR 21 1997

LAND CORNER RECORDATION CERTIFICATE
Filing Requirement of Act 74, Mich. P.A. 1970

KALKASKA COUNTY, MICHIGAN
RECEIVED
97 JAN 31 PM 3:19

For corners in

KALKASKA **COMMISSION**
(County)

Located In:

Corner Code #1

1996 REMONUMENTATION

- | | | |
|------------------------------------|--------------------------|-------|
| 1. Public Land Survey | T <u>26N</u> R <u>7W</u> | C-3 |
| | T _____ R _____ | _____ |
| | T _____ R _____ | _____ |
| | T _____ R _____ | _____ |
| 2. Property Controlling in Section | S _____ T _____ R _____ | _____ |
| | S _____ T _____ R _____ | _____ |
| 3. Miscellaneous Property in Sec. | S _____ T _____ R _____ | _____ |
| | S _____ T _____ R _____ | _____ |
4. Lot No. _____, Recorded Plat _____
5. Private Claims _____

Joan Hall
REGISTER

Register of Deeds Stamp & File Number

I, EUGENE FARRIER, in a field survey on Oct. 2, 1996, do hereby certify that under requirements of P.A. 74, Michigan P.A. of 1970, the corner points mentioned in lines 1 and 2 above were in conformance with regulations and rules therefore as required in the current manual of survey instructions of the United States Department of the Interior, Bureau of Land Management or by a decree of a Court of Law and/or that the corner points mentioned in lines 3, 4 and 5 above were in conformance with the rules of the Michigan Board of Land Surveyors or by a Decree of a Court of Law; established, re-established, monumented, re-monumented, recovered, found as expressed below:

A	B	C	D	E	F	G	H	I	J	K	L
2	6	5	4	3	2	1					
3		•									
4	7	8	9	10	11	12					
5											
6	16	17	16	15	14	13					
7											
8	19	20	21	22	23	24					
9											
10	30	29	28	27	26	25					
11											
12	31	32	33	34	35	36					
13											

NOTE: Not more than 4 corners, all in the same town and range, may be recorded on this certificate.

A. Description of original monument and accessories and/or subsequent restoration:

- C-03: Cor. common to Sec. 5, 6, 7, & 8, T26N-R7W, Orange Township 1849, GLO resurvey, set Beech post. 6" Beech, N45W, 20, 12" Beech, S84E, 33.
- Jun 09, 1881, E. Mosher, Co. Surveyor, used cor. no accessories.
- Feb 28, 1885, E. Mosher, Co. Surveyor, used cor. no accessories.
- Sep 13, 1890, E. Mosher, Co. Surveyor, used cor. no accessories.
- Apr 13, 1905, W.S. Merrill, Co. Surveyor, used cor. no accessories.
- 01-05-1973, LCRC Liber 1 Pg. 159, Granger Engineering set corner.
- 04-26-1978, Granger Engineering, fd 1" iron pipe. Liber 2 pg. 187.
- 04-26-1978, LCRC Liber 2 Pg. 100.
- 05-05-1978, J.L. Fletcher, fd 1" iron pipe. Liber 2 pg. 186 of Survey.
- 05-12-1987, LCRC Liber 2 Pg. 344.
- 05-12-1987, C.F. Roser, fd 3/4" x 2.5" x 12.5" cast iron & raised w/ 5/8" x 34" re-rod w/ cap w/ accessories. Fd cor. 12.82' South of Granger Engineering corner
- 02-16-1989, E.D. Farrier, Survey #1789, fd. 1" iron pipe w/ accessories.
- 09-04-1991, E.D. Farrier, Survey #14991, fd. DNR Brass Cap #12028 w/ accessories.

B. Description of corner evidence found and/or method applied in restoring or reestablishing corner:

C-03: Cor. common to Sec. 5, 6, 7, & 8, T26N-R7W, Orange Township Found 5/8" iron & cap #12028 and 3/4" x 2 1/2" x 12 1/2" iron w/ accessories. Pulled & Set 5/8" x 18" re-rod w/ Brass cap in mon box 4' North of centerline of Gregg Road & 6' West of centerline Prough Road to North. No G.L.O. witnesses were found. The Kalkaska Co. peer group approved & accepted the above monument as a careful and faithful reestablishment of the position of the original corner.

C. Description of monument for corner and accessories established to perpetuate localizing the position of the corner:

C-03: Cor. common to Sec. 5, 6, 7, & 8, T26N-R7W, Orange Township Found 5/8" iron & cap #12028 and 3/4" x 2 1/2" x 12 1/2" iron w/ accessories. Pulled & Set 5/8" x 18" re-rod w/ Brass cap in mon box 4' North of centerline of Gregg Road & 6' West of centerline Prough Road to North.

Fd nail & tag #12028 N83E Power Pole, 181.90'.


Set nail & tag S20E 4" Ash, 35.95'.

Set nail & tag S74W Power Pole, 142.15'.

N45W fd iron & cap #24594, 46.30'.

Ratified by Peer Group
P.A. 345 - 1990 Kalkaska County
Chairman *[Signature]*

Signed by *Eugene Farrier* Date 1-30-97
Surveyor's Michigan License No. 24594

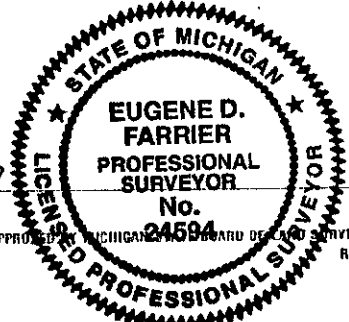

FORM APPROVED BY MICHIGAN BOARD OF LAND SURVEYORS, JAN. 28, 1971
REVISED MAY 14, 1975
REVISED JAN., 1988